


LINCOLN COUNTY

SECTION SUMMARY

14 - 32 - 7
Section - Town - Range

SCHLEY
Township

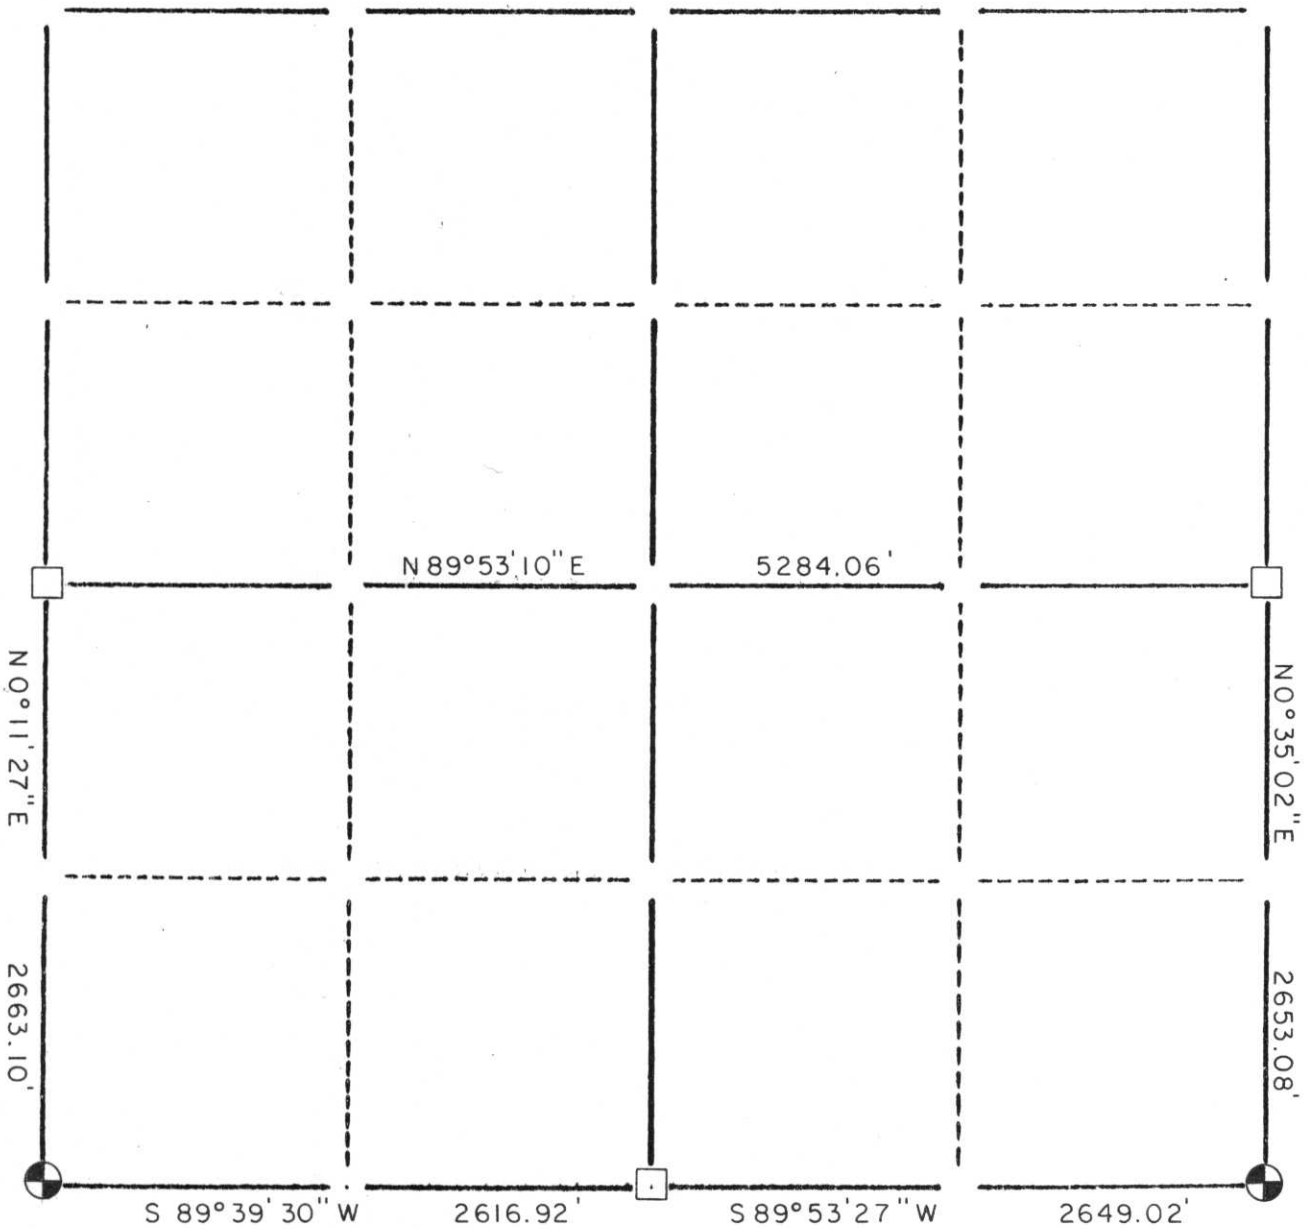

LEGEND

- - LINCOLN COUNTY BERNTSEN MONUMENT
- - Stone or Concrete Monument
- - 2" Iron Pipe
- - 1" Iron Pipe
- - Iron Bar
- - NAIL



CERTIFIED CORRECT:
Edwin Abendroth
 RLS No. S-798
 Registered Land Surveyor
 DATE: *March 18, 1998*

RECEIVED AT LINCOLN COUNTY
 COURTHOUSE THIS *23rd* DAY
 OF *March* 19 *98*
Dot Priebe
 TAX DESCRIPTION OFFICE

I-M: 17-21