




SECTION SUMMARY $\frac{17}{\text{Section}} - \frac{32}{\text{Township}} - \frac{7E}{\text{Range}}$
MERRILL
 Town

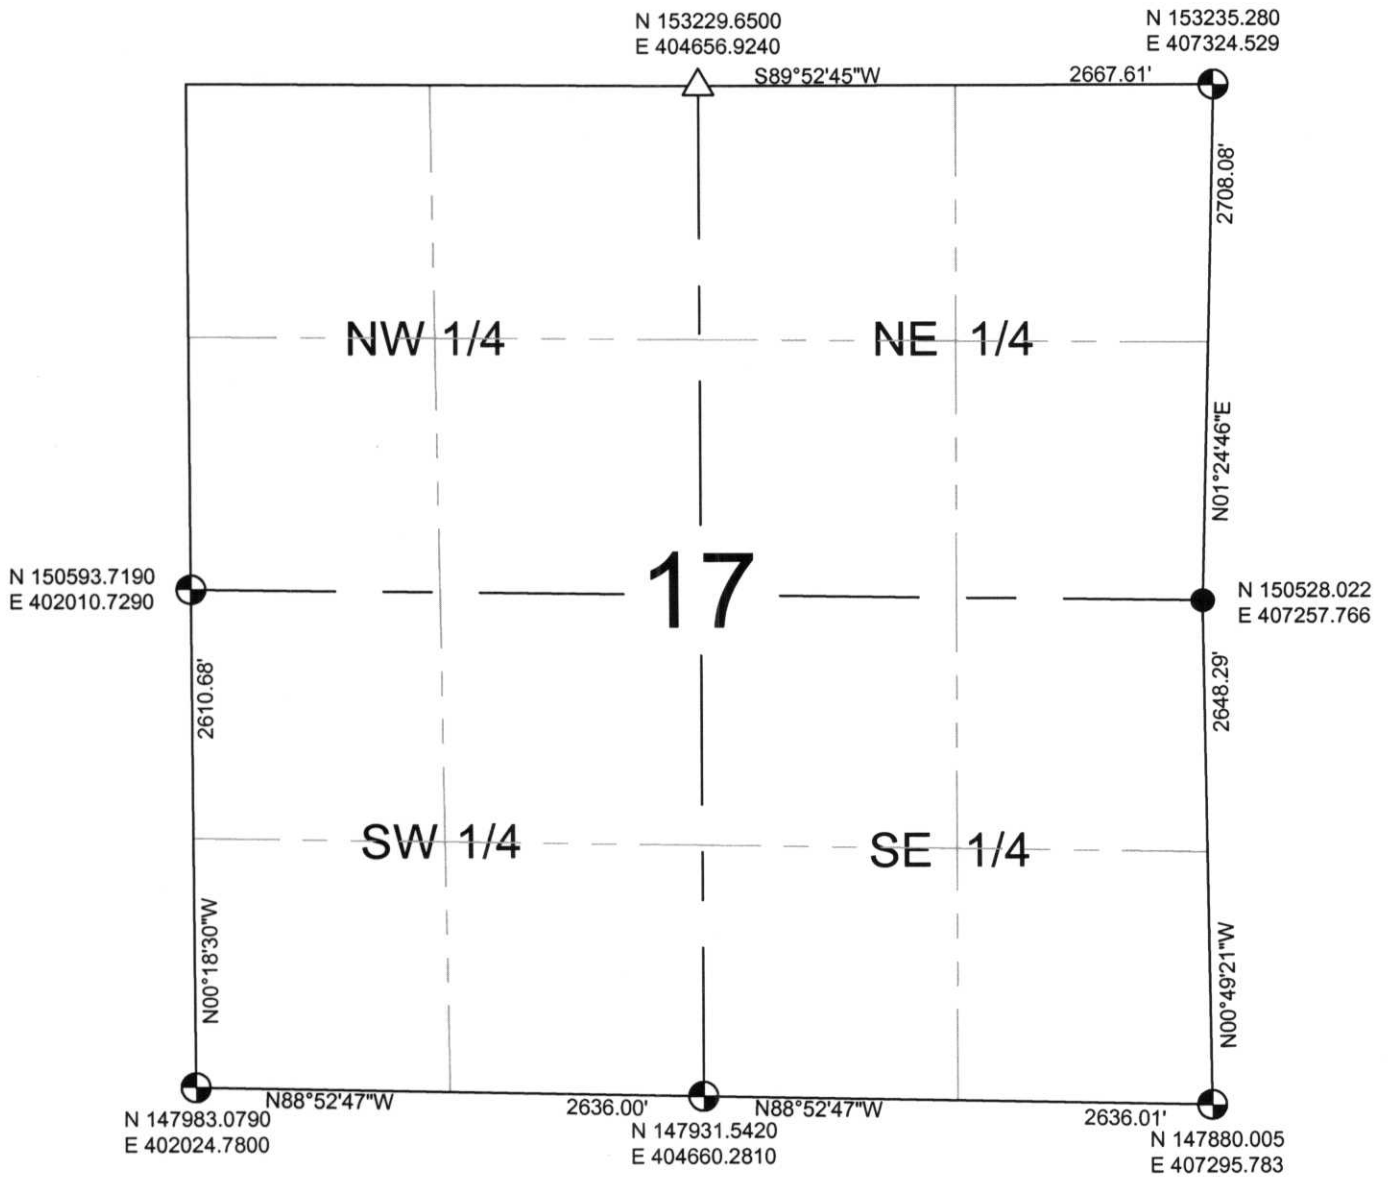

NOTES:
 COORDINATES AND BEARINGS ARE REFERENCED TO THE LINCOLN COUNTY COORDINATE SYSTEM AS DEVELOPED BY THE WISCONSIN DEPARTMENT OF TRANSPORTATION AND WERE DETERMINED BY GPS OBSERVATIONS ON CONTROL POINTS AS SUPPLIED BY THE DOT.

- LEGEND**
- - Lincoln County Monument
 - - Stone or Concrete Monument
 - - 1" Iron Pipe
 - - Swamp Rod
 - △ - P.K. Nail

RECEIVED AT LINCOLN COUNTY
 COURTHOUSE THIS 3RD DAY
 OF December 20 02
Tony Walker
 LAND INFORMATION OFFICE



CERTIFIED CORRECT
David Renaud
 Registered Land Surveyor
 DATE: 11-29-02

I-M: 5-9