





SECTION SUMMARY  
 21 - 32 - 7E  
 Section Township Range  
**MERRILL**  
 Town

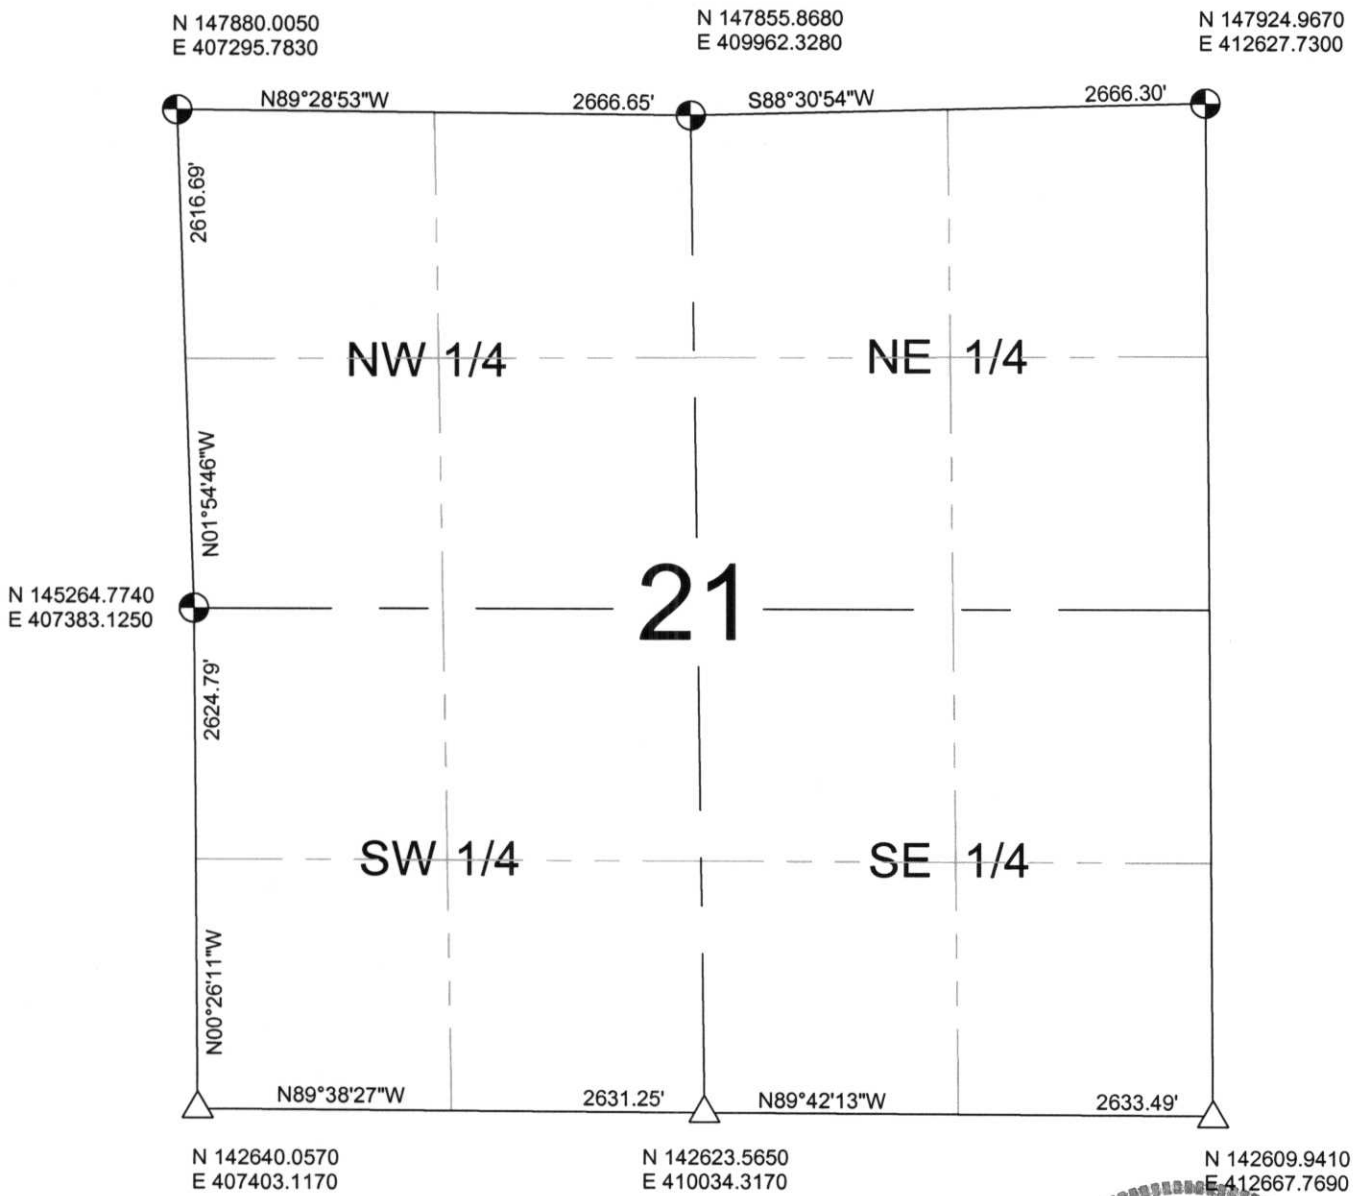

NOTES:  
 COORDINATES AND BEARINGS ARE REFERENCED TO THE LINCOLN COUNTY COORDINATE SYSTEM AS DEVELOPED BY THE WISCONSIN DEPARTMENT OF TRANSPORTATION AND WERE DETERMINED BY GPS OBSERVATIONS ON CONTROL POINTS AS SUPPLIED BY THE DOT.

- LEGEND**
- - Lincoln County Monument
  - - Stone or Concrete Monument
  - - 1" Iron Pipe
  - - Iron Bar
  - △ - P.K. Nail

RECEIVED AT LINCOLN COUNTY  
 COURTHOUSE THIS 5<sup>TH</sup> DAY  
 OF December, 20 02  
*Tomy Path*  
 LAND INFORMATION OFFICE

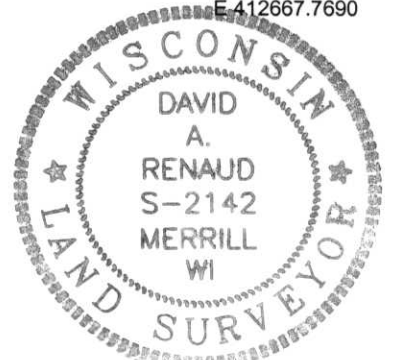

CERTIFIED CORRECT:  
*David A. Renaud*  
 Registered Land Surveyor  
 DATE: 12-04-02

17, 0 - 9, 13