


LINCOLN county surveyor

SECTION SUMMARY

33 - 32 - 7
Section - Town - Range
MERRILL
Township

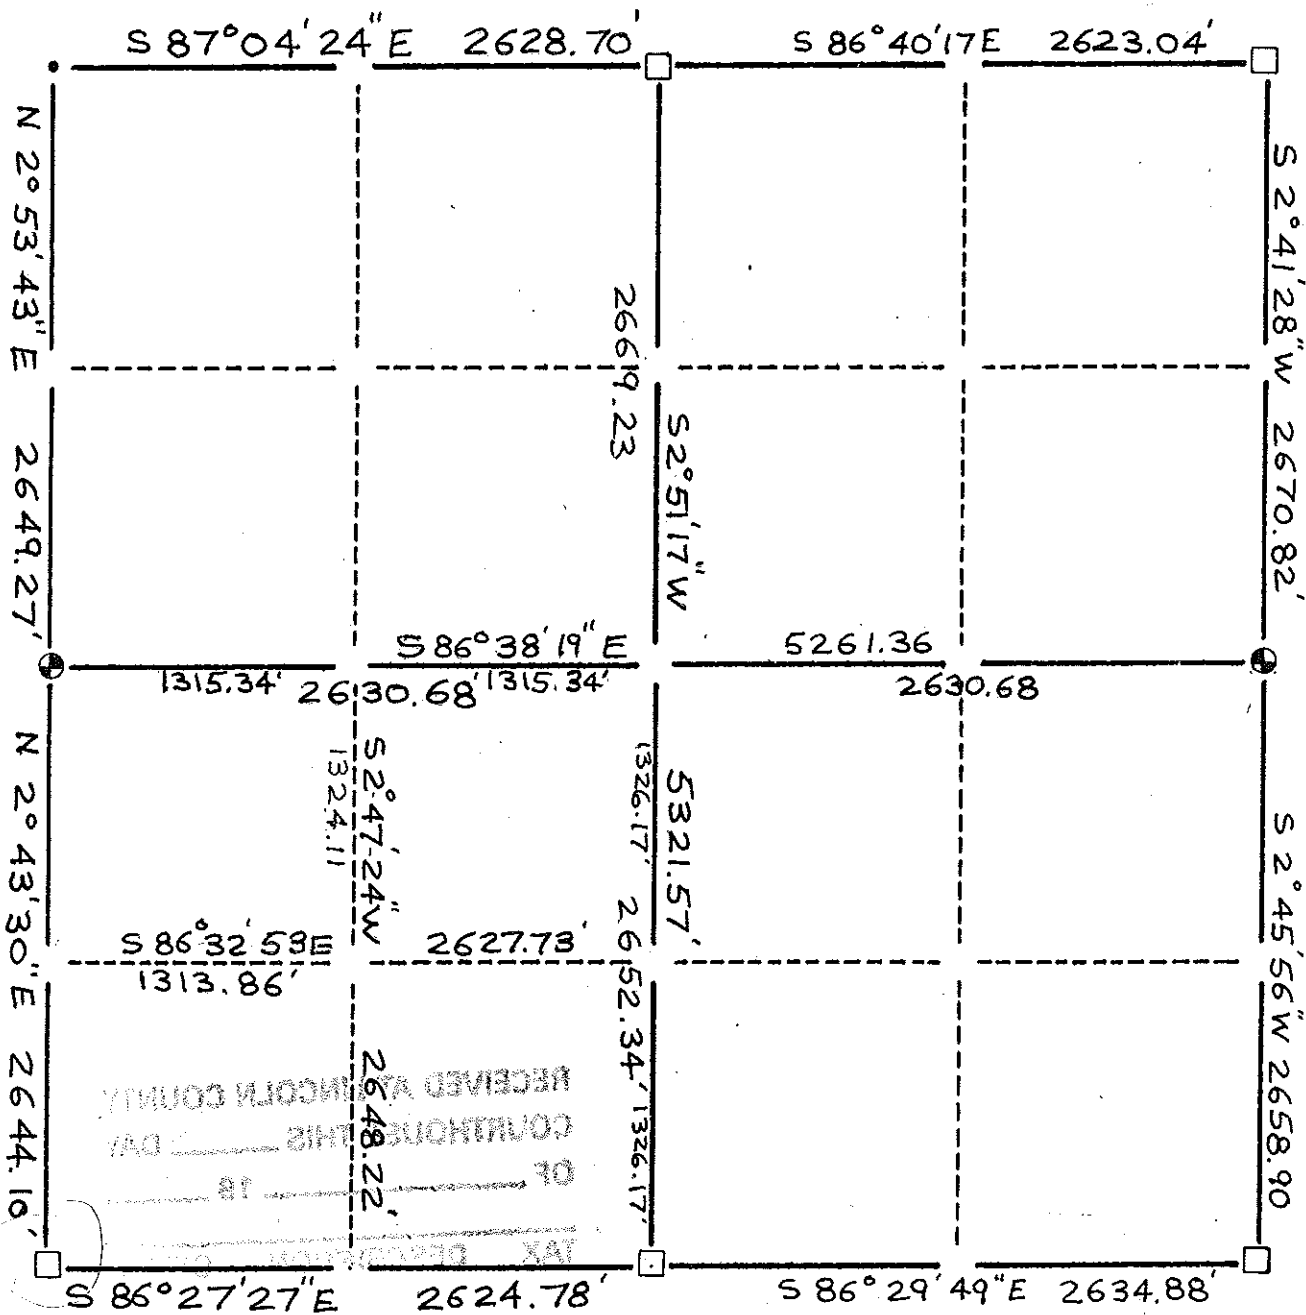

LEGEND

- BERNTSEN
- ⊕ - Harrison Cast Iron Monument
- - Stone or Concrete Monument
- - 2" Iron Pipe
- - 1" Iron Pipe
- - Iron Bar
- - Other PK NAIL

CERTIFIED CORRECT:

Edmund R. Ahrens

S-798
Registered Land Surveyor

DATE:

9-20-93

SEAL