




North



SECTION SUMMARY

34 - 32 - 7E  
 Section Township Range  
**MERRILL**  
 Town

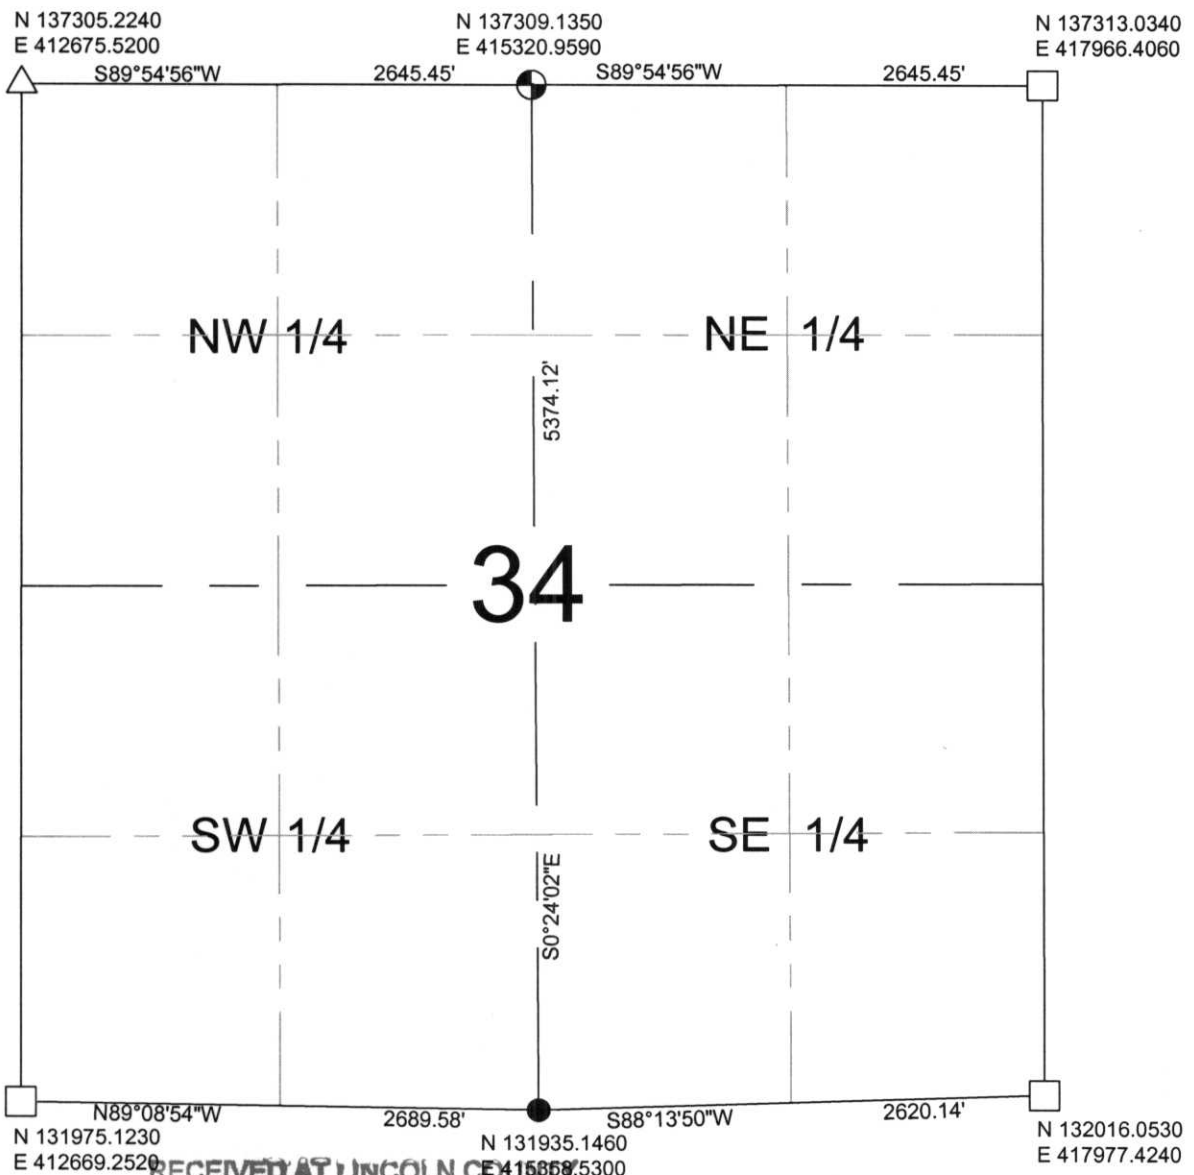

RECEIVED AT LINCOLN COUNTY  
 COURTHOUSE THIS 30 DAY  
 OF December 20 02  
*Tom Hall*  
 LAND INFORMATION OFFICE



NOTES:  
 COORDINATES AND BEARINGS ARE REFERENCED TO THE LINCOLN COUNTY COORDINATE SYSTEM AS DEVELOPED BY THE WISCONSIN DEPARTMENT OF TRANSPORTATION AND WERE DETERMINED BY GPS OBSERVATIONS ON CONTROL POINTS AS SUPPLIED BY THE DOT.

**LEGEND**


- - Lincoln County Monument
- - Stone or Concrete Monument
- - 1" Iron Pipe
- - Swamp Rod
- △ - P.K. Nail

CERTIFIED CORRECT:

*David Renaud*  
 Registered Land Surveyor

DATE: 11-29-02



C-9: 13-17

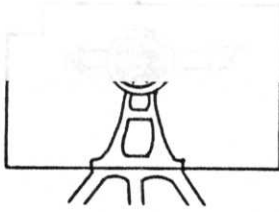

**LINCOLN**  
**county**  
**surveyor**

**SUMMARY**

34 - 32 - 7  
Section    Town    Range  
MERRILL  
Township

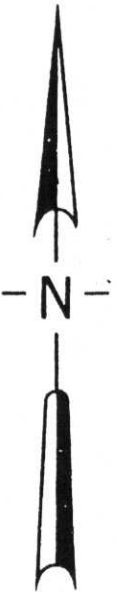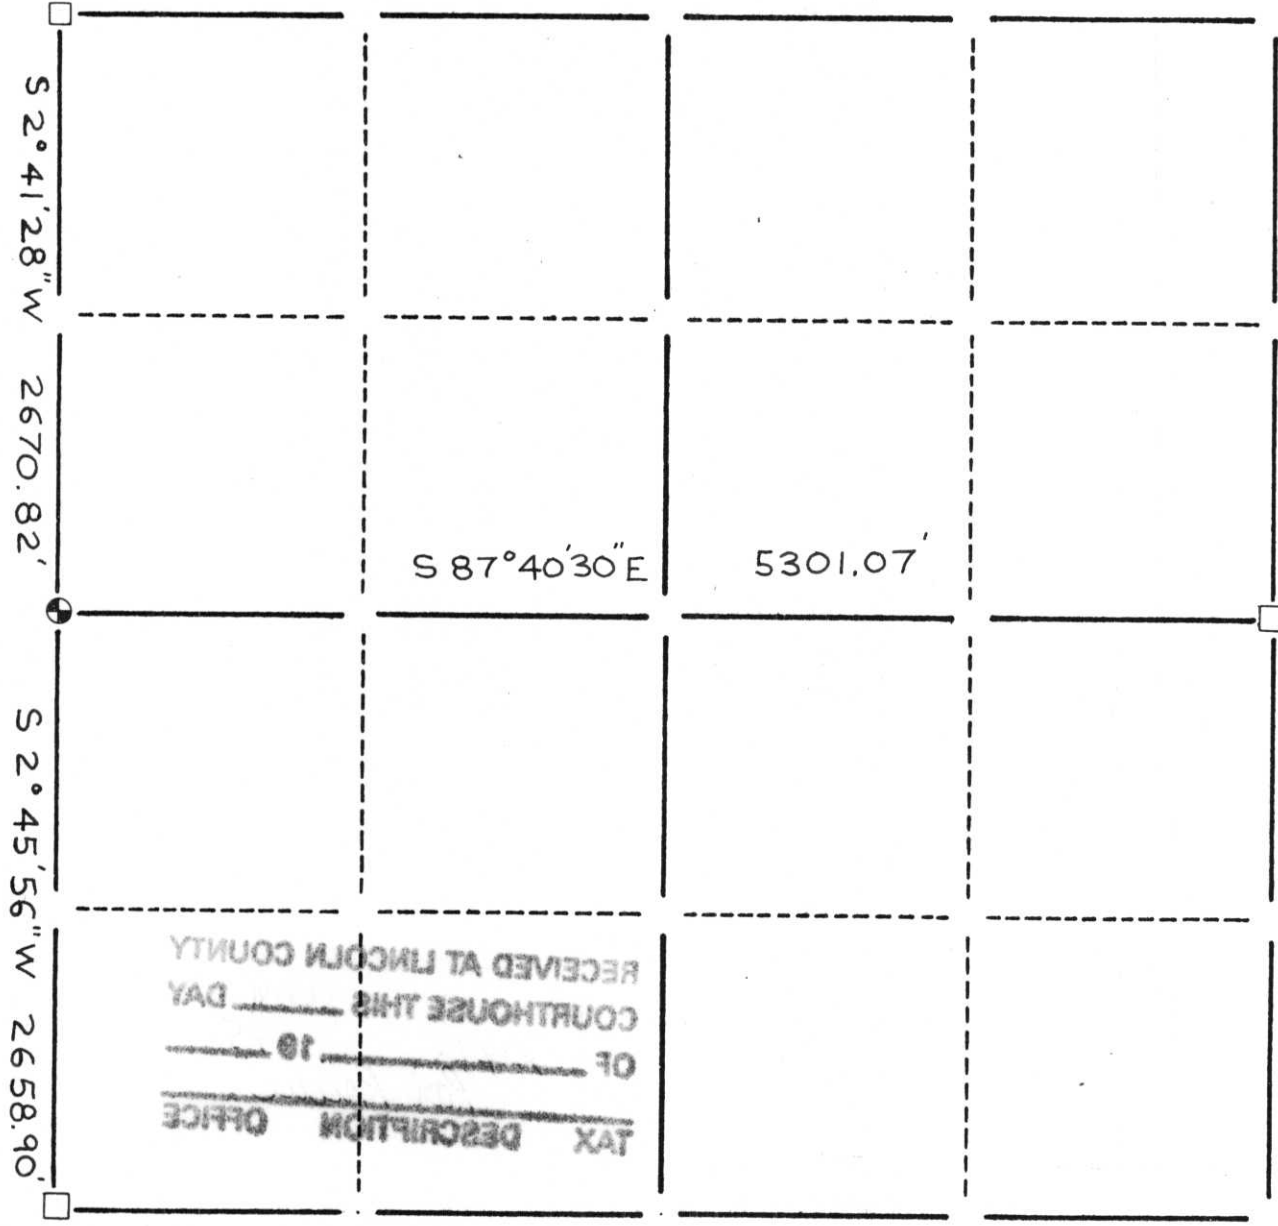

TAX DESCRIPTION OFFICE  
OF \_\_\_\_\_  
COURTHOUSE THIS DAY \_\_\_\_\_  
RECEIVED AT LINCOLN COUNTY

**LEGEND**

- ⊕ - Harrison Cast Iron Monument
- - Stone or Concrete Monument
- - 2" Iron Pipe
- - 1" Iron Pipe
- - Iron Bar
- Other

SEAL

GERTIFIED CORRECT:  
*Edmund R. Alendroath*  
 S-798  
 Registered Land Surveyor  
 DATE: 9-20-95

0-9:13-17