


SCHLEY

Township



SECTION SUMMARY

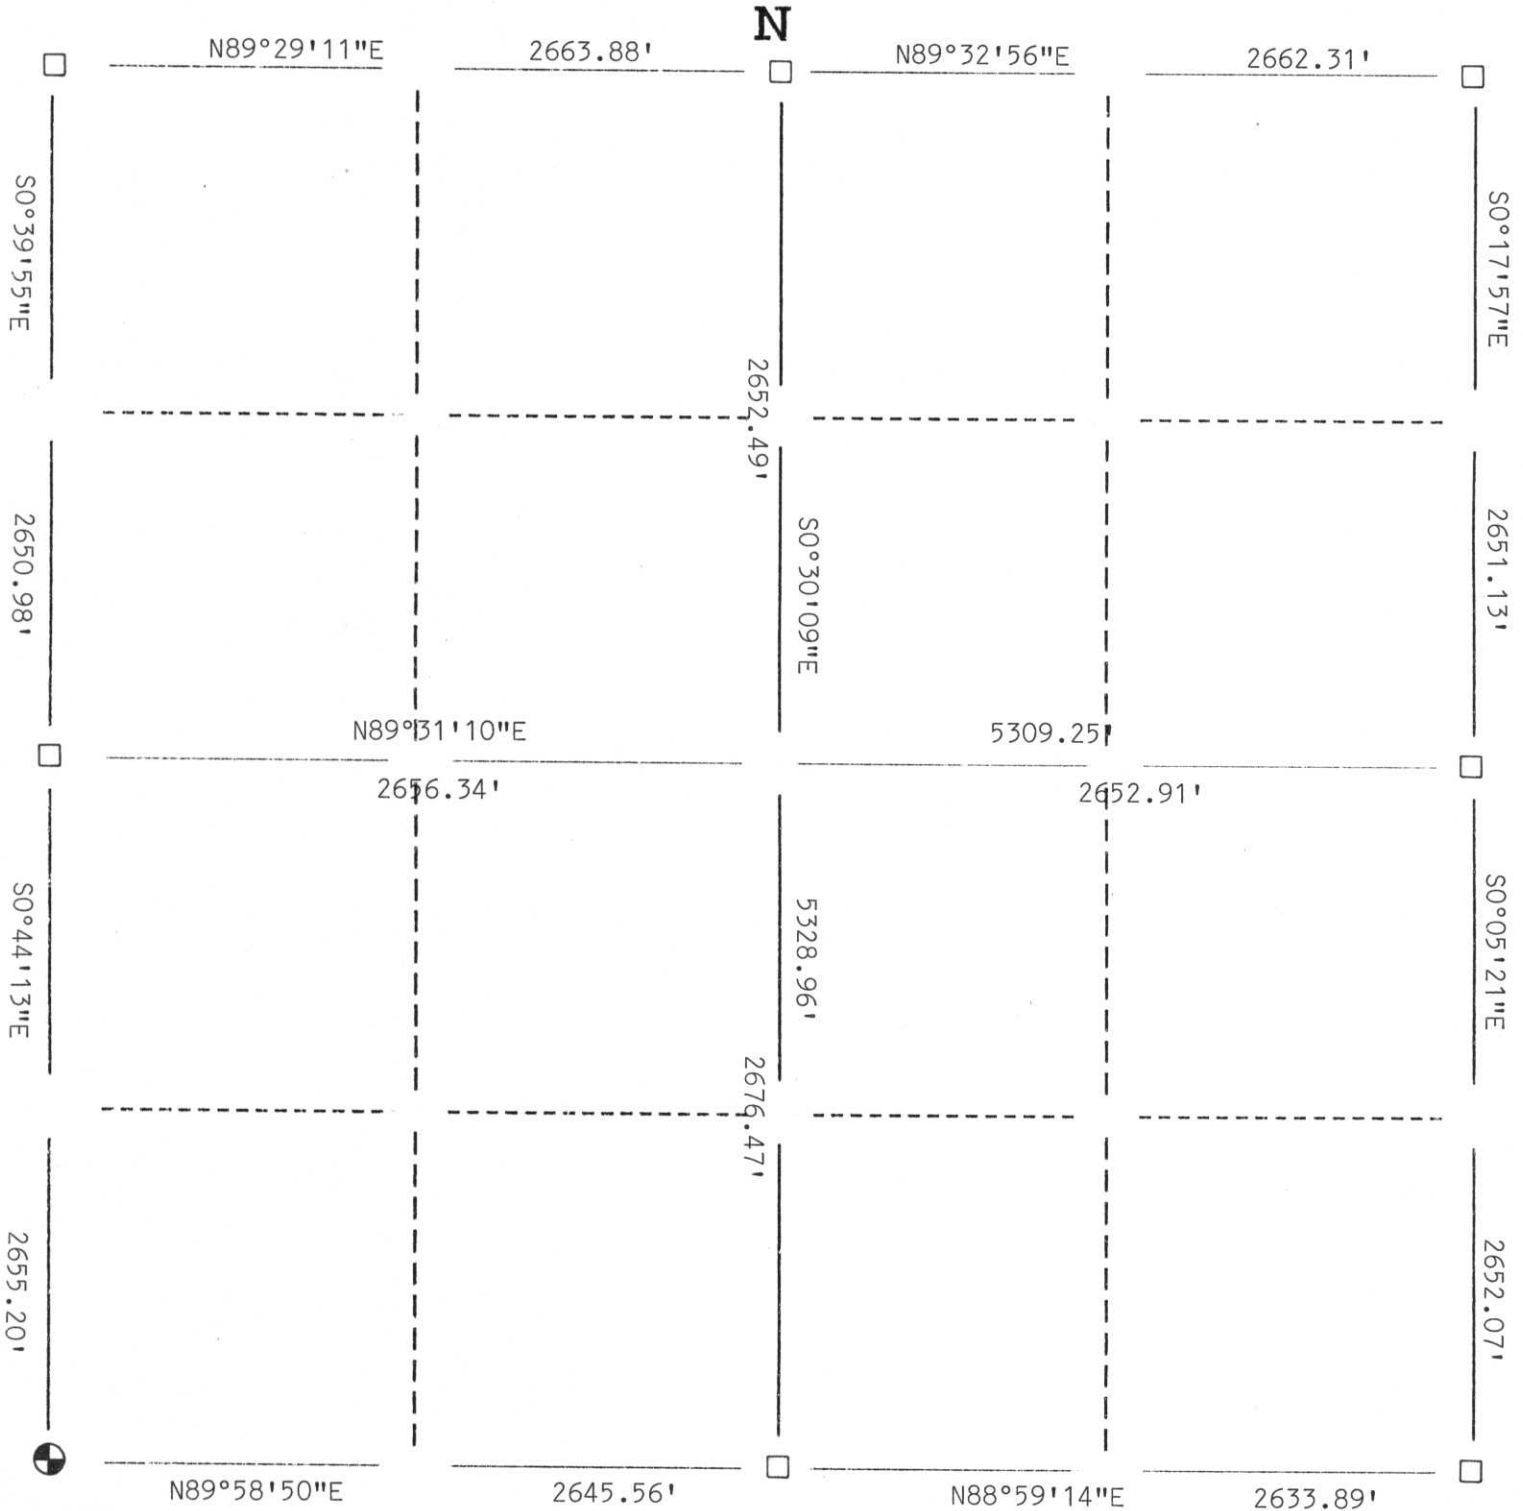

LEGEND

- ⊕ Berntsen Monument
- 2" Iron Pipe
- Stone or Concrete Monument
- 1" Iron Pipe
- Iron Pipe
- Other



RECEIVED AT LINCOLN COUNTY
COURTHOUSE THIS 1st DAY
OF Feb 2000
Pat Priebe
LAND INFORMATION OFFICE

CERTIFIED CORRECT:

David J. Goslin

David J. Goslin RLS No. 2280

Registered Land Surveyor

DATE: 1-20-00

0-9:21-25