




3 - 32 - 8
Section Township Range

SCHLEY
Township

SECTION SUMMARY

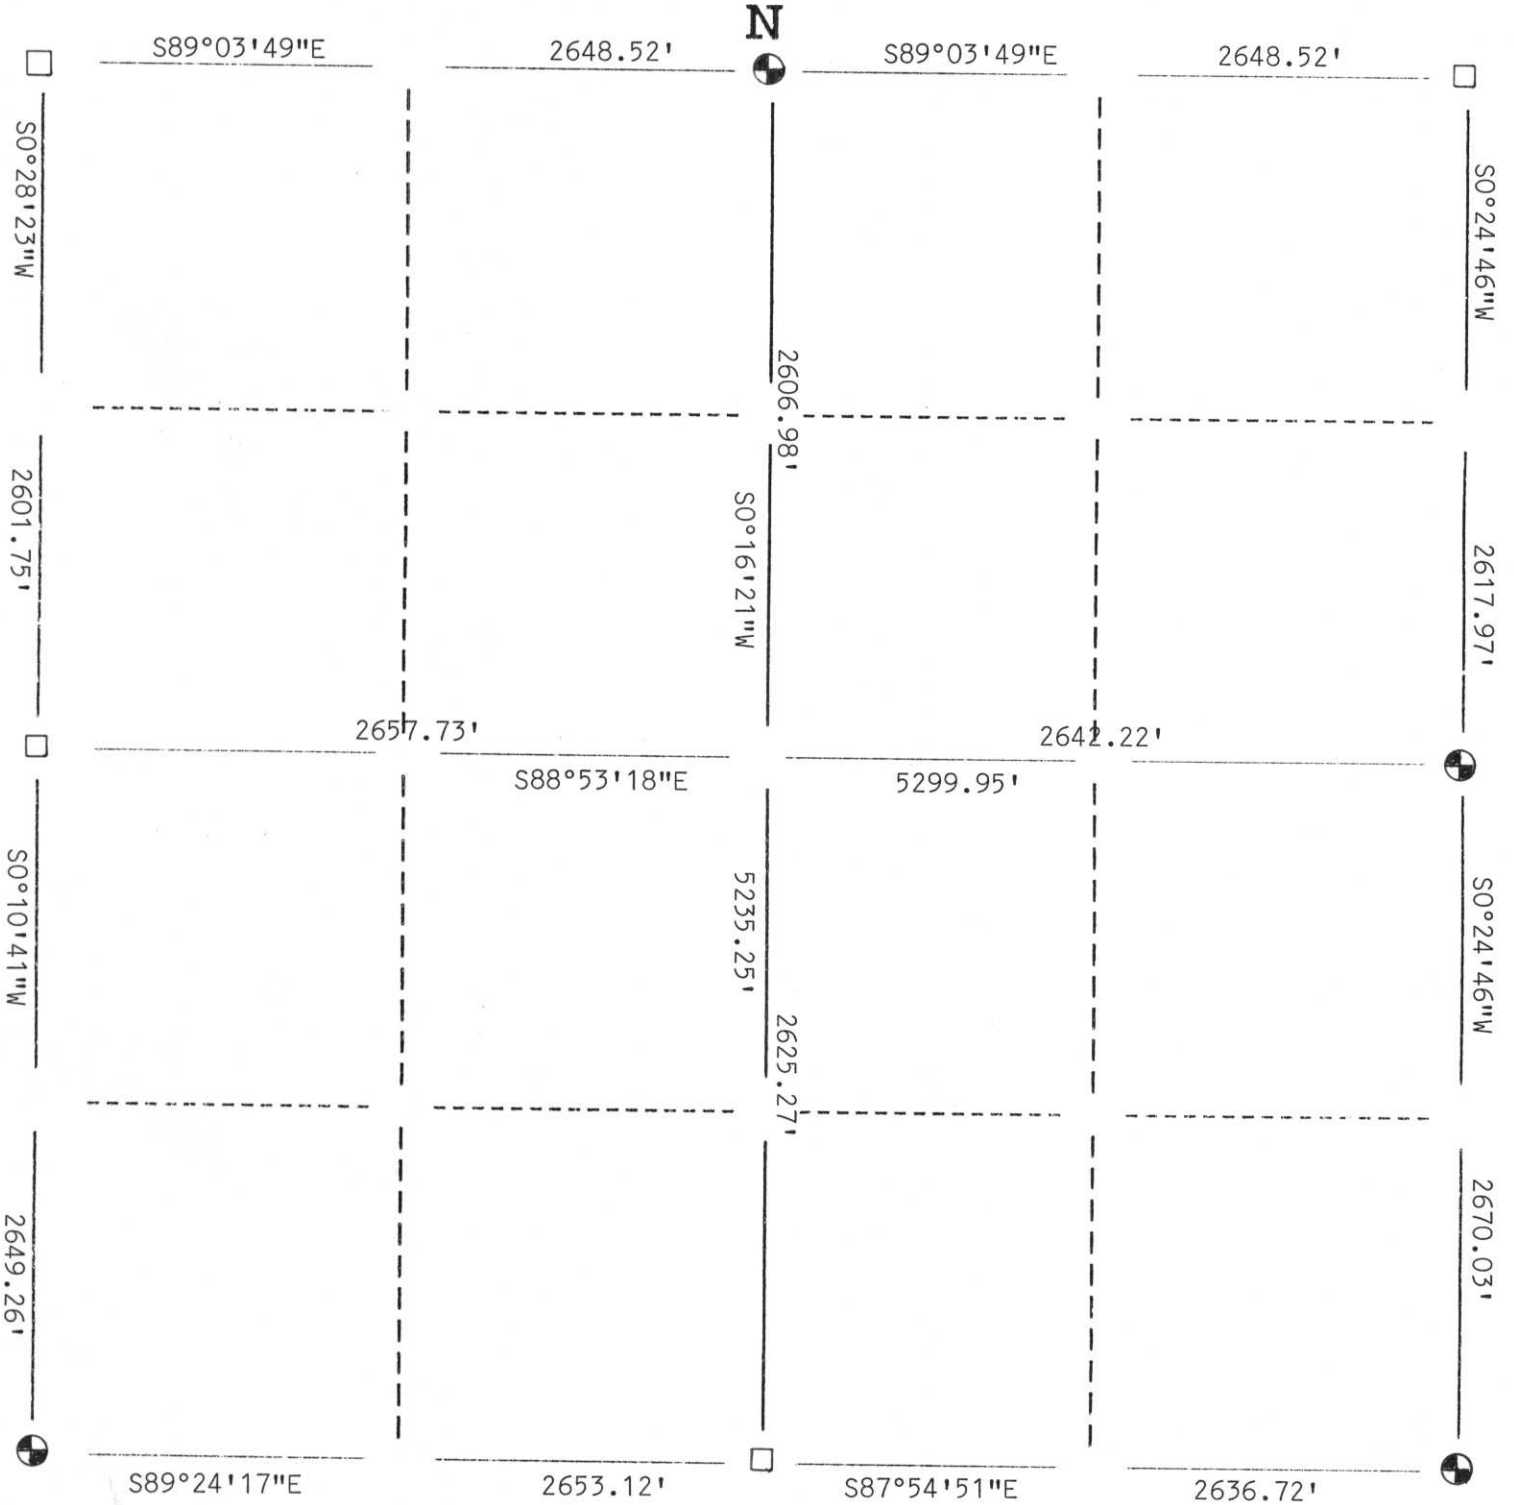

LEGEND

- Berntsen Monument
- 2" Iron Pipe
- Stone or Concrete Monument
- 1" Iron Pipe
- Iron Pipe
- Other



CERTIFIED CORRECT:

David J. Goslin

David J. Goslin RLS S-2280

Registered Land Surveyor

DATE: 5-7-99

AE: 13,17