




North  
↑

SECTION SUMMARY

5 - T32N - R8E  
 Section Township Range  
 SCHLEY  
 Town

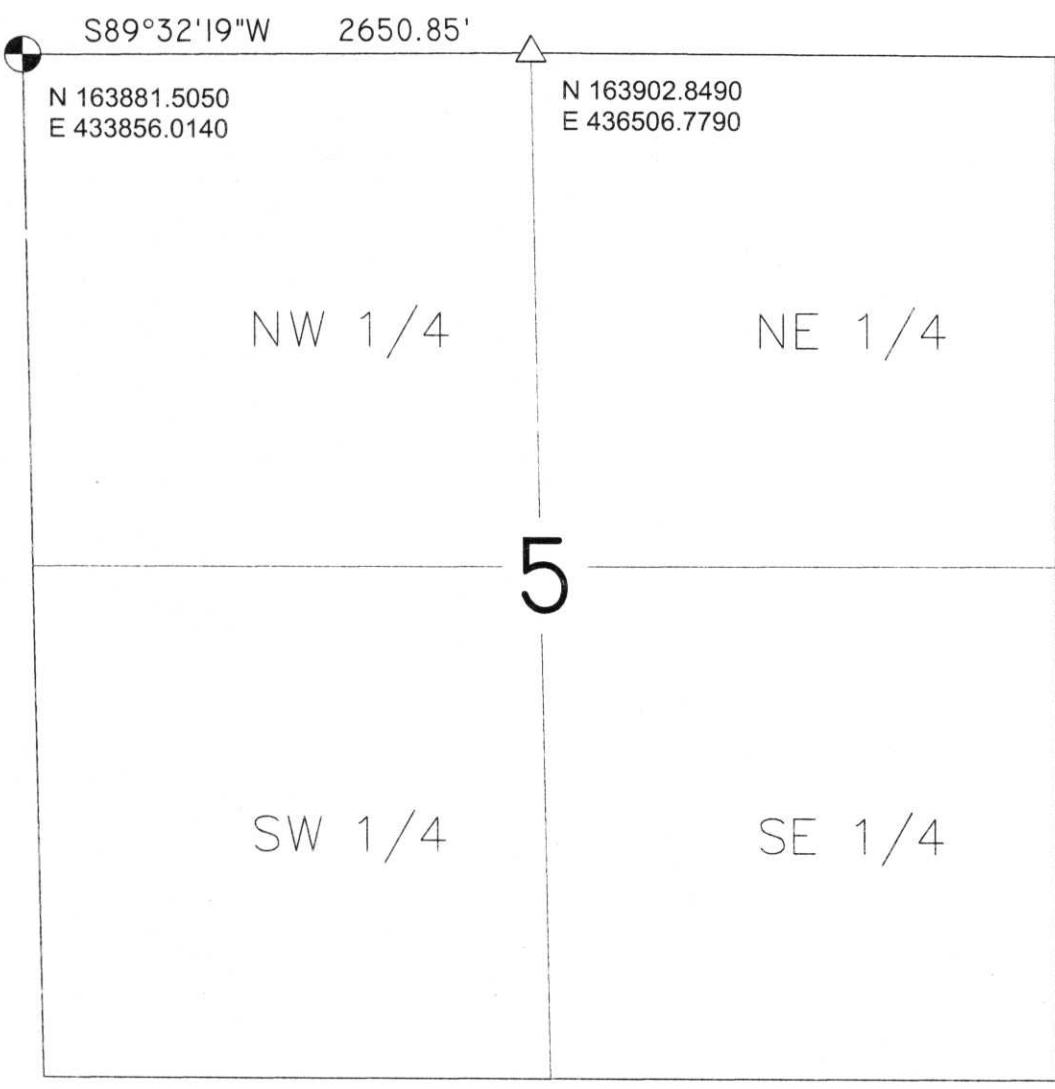

NOTES:  
 1-COORDINATES & BEARINGS BASED ON LINCOLN COUNTY COORDINATE SYSTEM.

- LEGEND**
- ⊕ -BERNSTEN MONUMENT
  - -GRANITE STONE
  - -1 1/2" IRON PIPE
  - -2" IRON PIPE
  - △ -PK NAIL
  - ▲ -RR SPIKE
  - -LOCATION FROM TIES
  - ⊙ -3/4" REBAR



RECEIVED BY LINCOLN COUNTY SURVEYOR THIS 16<sup>TH</sup> DAY OF September 20 04  
*Tony Dall*  
 COUNTY SURVEYOR

CERTIFIED CORRECT:  
 DAVID A. RENAUD  
*David Renaud*  
 Registered Land Surveyor  
 DATE: 9-15-04

AE: 5, 9