




North



SECTION SUMMARY

8 - T32N - R8E  
 Section Township Range  
 SCHLEY  
 Town

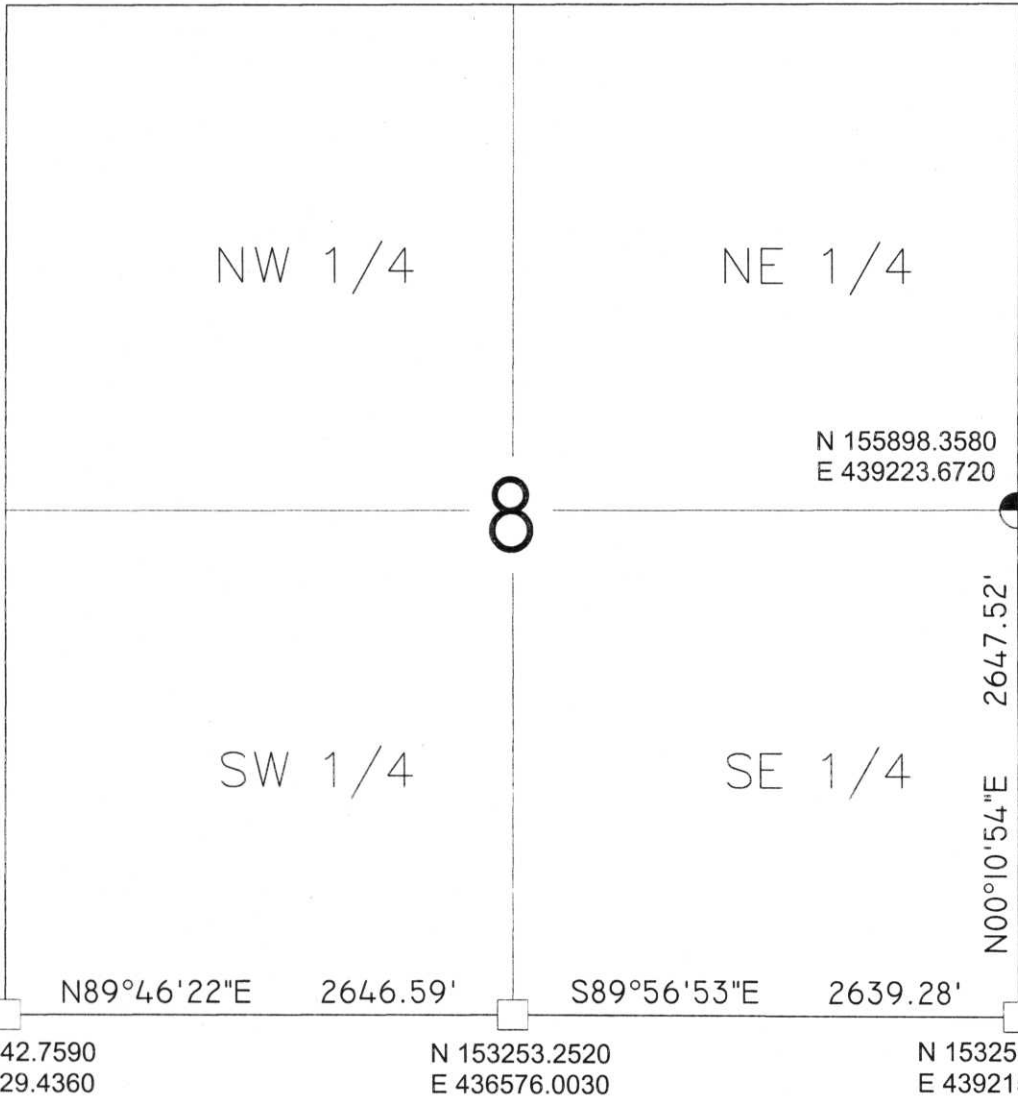

NOTES:  
 1-COORDINATES & BEARINGS BASED ON LINCOLN COUNTY COORDINATE SYSTEM.

LEGEND

- ⊕ -BERNSTEN MONUMENT
- -GRANITE STONE
- -1 1/2" IRON PIPE
- -2" IRON PIPE
- △ -PK NAIL
- ▲ -RR SPIKE
- -LOCATION FROM TIES
- ⊙ -3/4" REBAR



RECEIVED BY LINCOLN COUNTY  
 SURVEYOR THIS 16<sup>TH</sup> DAY  
 OF September 20 04  
*Tony Dull*  
 COUNTY SURVEYOR

CERTIFIED CORRECT:

DAVID A. RENAUD

*David Renaud*  
 Registered Land Surveyor

DATE: 9-15-04

R.E.I. 4080 N. 20th AVE WAUSAU, WI 54401 (715)675-9784

FI: 5,9