



LINCOLN  
**county  
surveyor**

**SECTION  
SUMMARY**

9 Section 32 Range  
SCHLEY  
Township

~~Sec 9-32-8~~

Sec 9-32-8

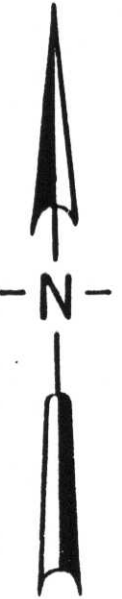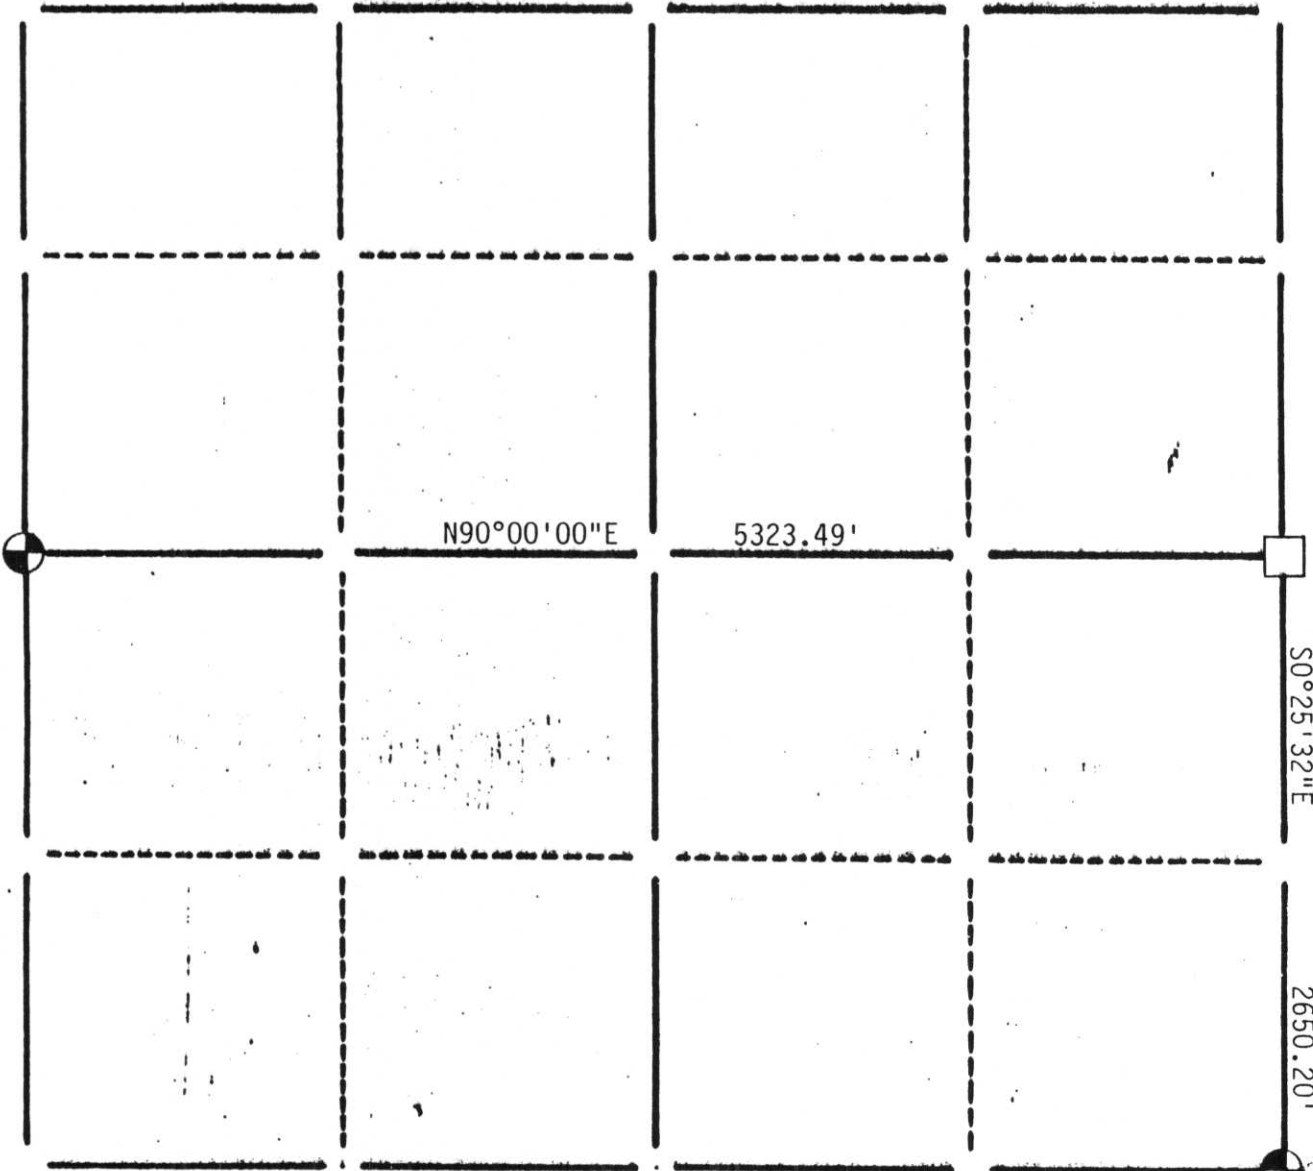

**LEGEND**

- Berntsen Aluminum Monument
- Stone or Concrete Monument
- 
- 
- Iron Bar
- Other

SEAL



RECEIVED AT LINCOLN COUNTY  
COURTHOUSE THIS 29th DAY  
OF Oct. 19 96

Pat Priebe

TAX DESCRIPTION OFFICE

CERTIFIED CORRECT

David L. Osterbrink  
Registered Land Surveyor

DATE: 10-27-96

EL: 9,13