




North  
↑

SECTION SUMMARY

34 - T32N - R8E  
Section Township Range  
SCHLEY  
Town

N 137308.6590  
E 449775.4620

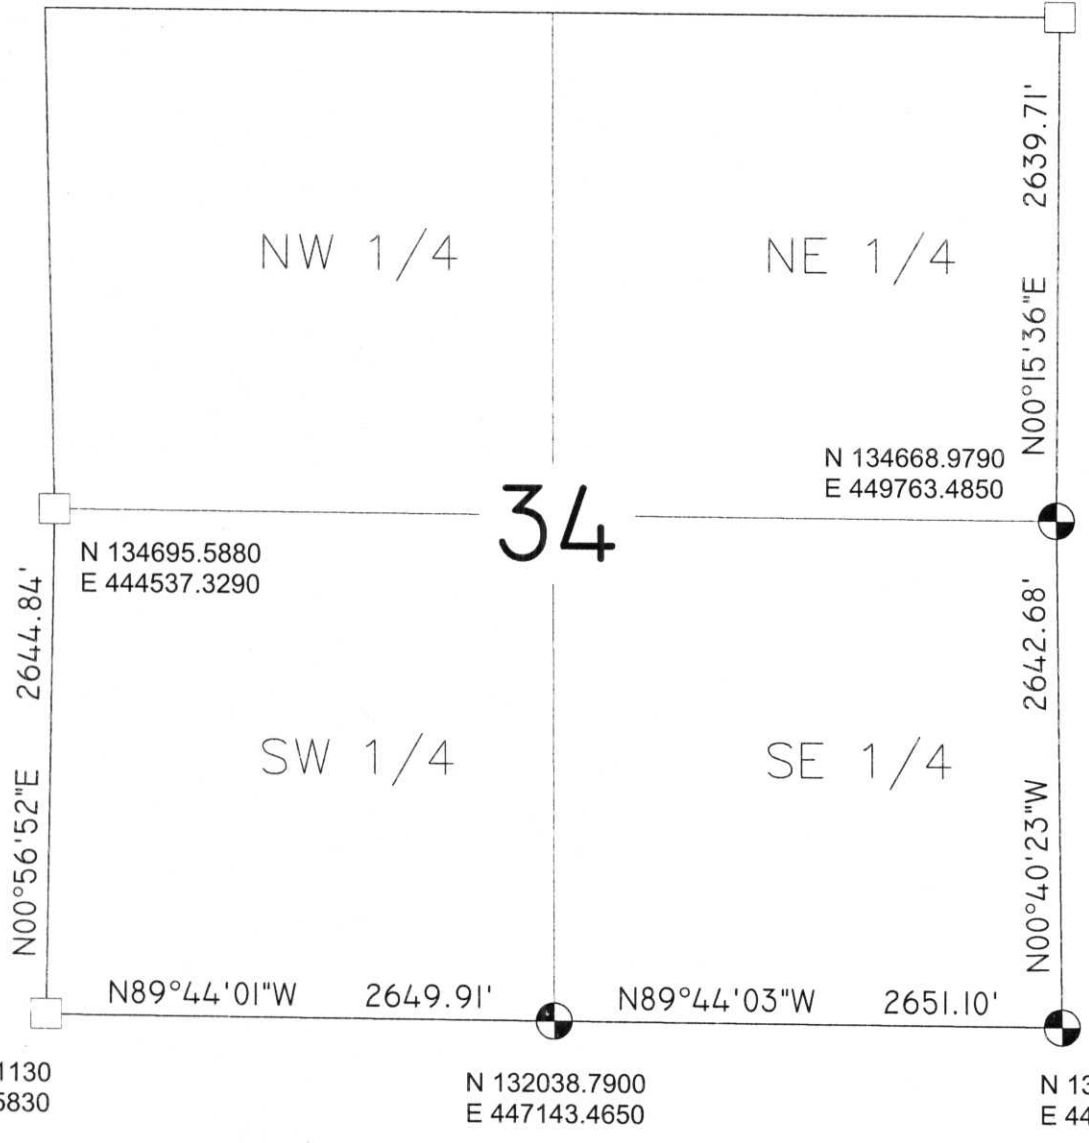

N 132051.1130  
E 444493.5830

N 132038.7900  
E 447143.4650

N 132026.4850  
E 449794.5340

NOTES:  
1-COORDINATES & BEARINGS BASED ON LINCOLN COUNTY COORDINATE SYSTEM.

- LEGEND**
- ⊙ -BERNSTEN MONUMENT
  - -GRANITE STONE
  - -1 1/2" IRON PIPE
  - -2" IRON PIPE
  - △ -PK NAIL
  - ▲ -RR SPIKE
  - -LOCATION FROM TIES
  - ⊙ -3/4" REBAR



RECEIVED BY LINCOLN COUNTY SURVEYOR THIS 16<sup>TH</sup> DAY OF September 20 04  
Tony Dull  
COUNTY SURVEYOR

CERTIFIED CORRECT:  
DAVID A. RENAUD  
David Renaud  
Registered Land Surveyor  
DATE: 9-15-04

04: 13, 17