




North



SECTION SUMMARY

36 - T32N - R8E  
 Section Township Range  
 SCHLEY  
 Town

N 137322.0810  
 E 455056.9650

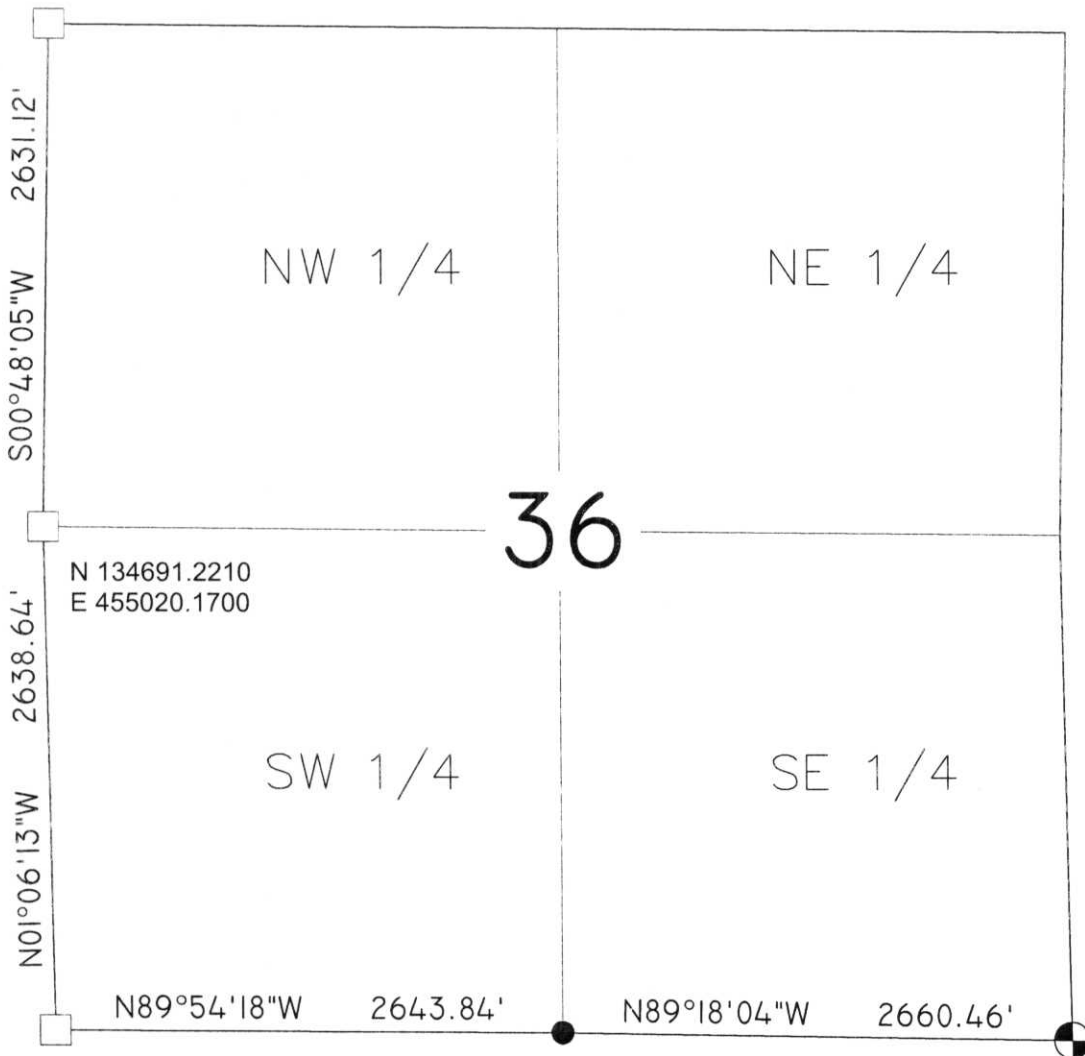

N 132053.0660  
 E 455070.9910

N 132048.6760  
 E 457714.8230

N 132016.2310  
 E 460375.0900

NOTES:  
 1-COORDINATES & BEARINGS BASED ON LINCOLN COUNTY COORDINATE SYSTEM.

LEGEND

- ⊕ -BERNSTEN MONUMENT
- -GRANITE STONE
- -1 1/2" IRON PIPE
- -2" IRON PIPE
- △ -PK NAIL
- ▲ -RR SPIKE
- -LOCATION FROM TIES
- ⊙ -3/4" REBAR



RECEIVED BY LINCOLN COUNTY  
 SURVEYOR THIS 16<sup>TH</sup> DAY  
 OF September 20 04  
*Tony Dahl*  
 COUNTY SURVEYOR

CERTIFIED CORRECT:

DAVID A. RENAUD

*David Renaud*

Registered Land Surveyor

DATE: 9-15-04

CY: 21,25