


**SUMMARY OF PART OF THE EAST LINE OF  
SECTION 13  
TOWNSHIP 33 NORTH  
RANGE 4 EAST  
CORNING TOWNSHIP  
LINCOLN COUNTY, WISCONSIN**

**SECTION  
CORNER**  
6" X 6" GRANITE  
STONE MONUMENT  
FOUND  
N 185278.29  
E 333174.09


2652.18'  
S00°39'02"W

**E 1/4  
CORNER**  
6" X 6" GRANITE  
STONE MONUMENT  
FOUND  
N 182626.28  
E 333143.98

LINCOLN  
COUNTY GRID  
COORDINATES

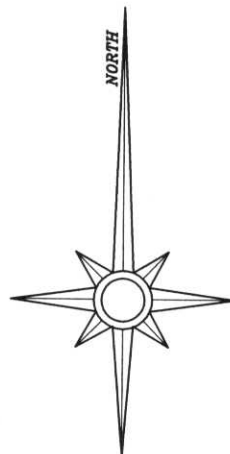

RECEIVED BY LINCOLN COUNTY  
SURVEYOR THIS 14<sup>TH</sup> DAY  
OF December 20 04  
Tony Dalk  
COUNTY SURVEYOR

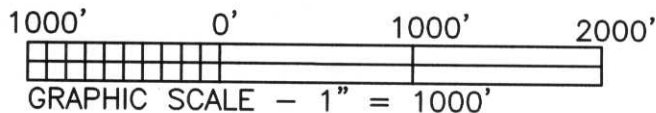

I hereby certify that I have surveyed the property shown hereon; that this map represents an accurate survey of said property to the best of my knowledge and belief; and that I have complied with the applicable requirements of the Wisconsin Administrative Code Section A-E 7.

Stephen J. Favorite      12-10-04  
Stephen J. Favorite      Date

SURVEY FOR:	
LINCOLN COUNTY LAND INFORMATION OFFICE 1106 E 8TH STREET MERRILL, WI 54452	
	<b>FAVORITE SURVEYING, S.C.</b>
	5230 HWY 70 WEST      MAP NO. 2004074A
	EAGLE RIVER, WI 54521      DATE: 12-10-04
	PHONE: (715) 479-2570      DWN BY: JDA
FAX: (715) 479-7274      SCALE: 1" = 1000'	

I, M: 21, 25