




HARDING
Township

SECTION SUMMARY

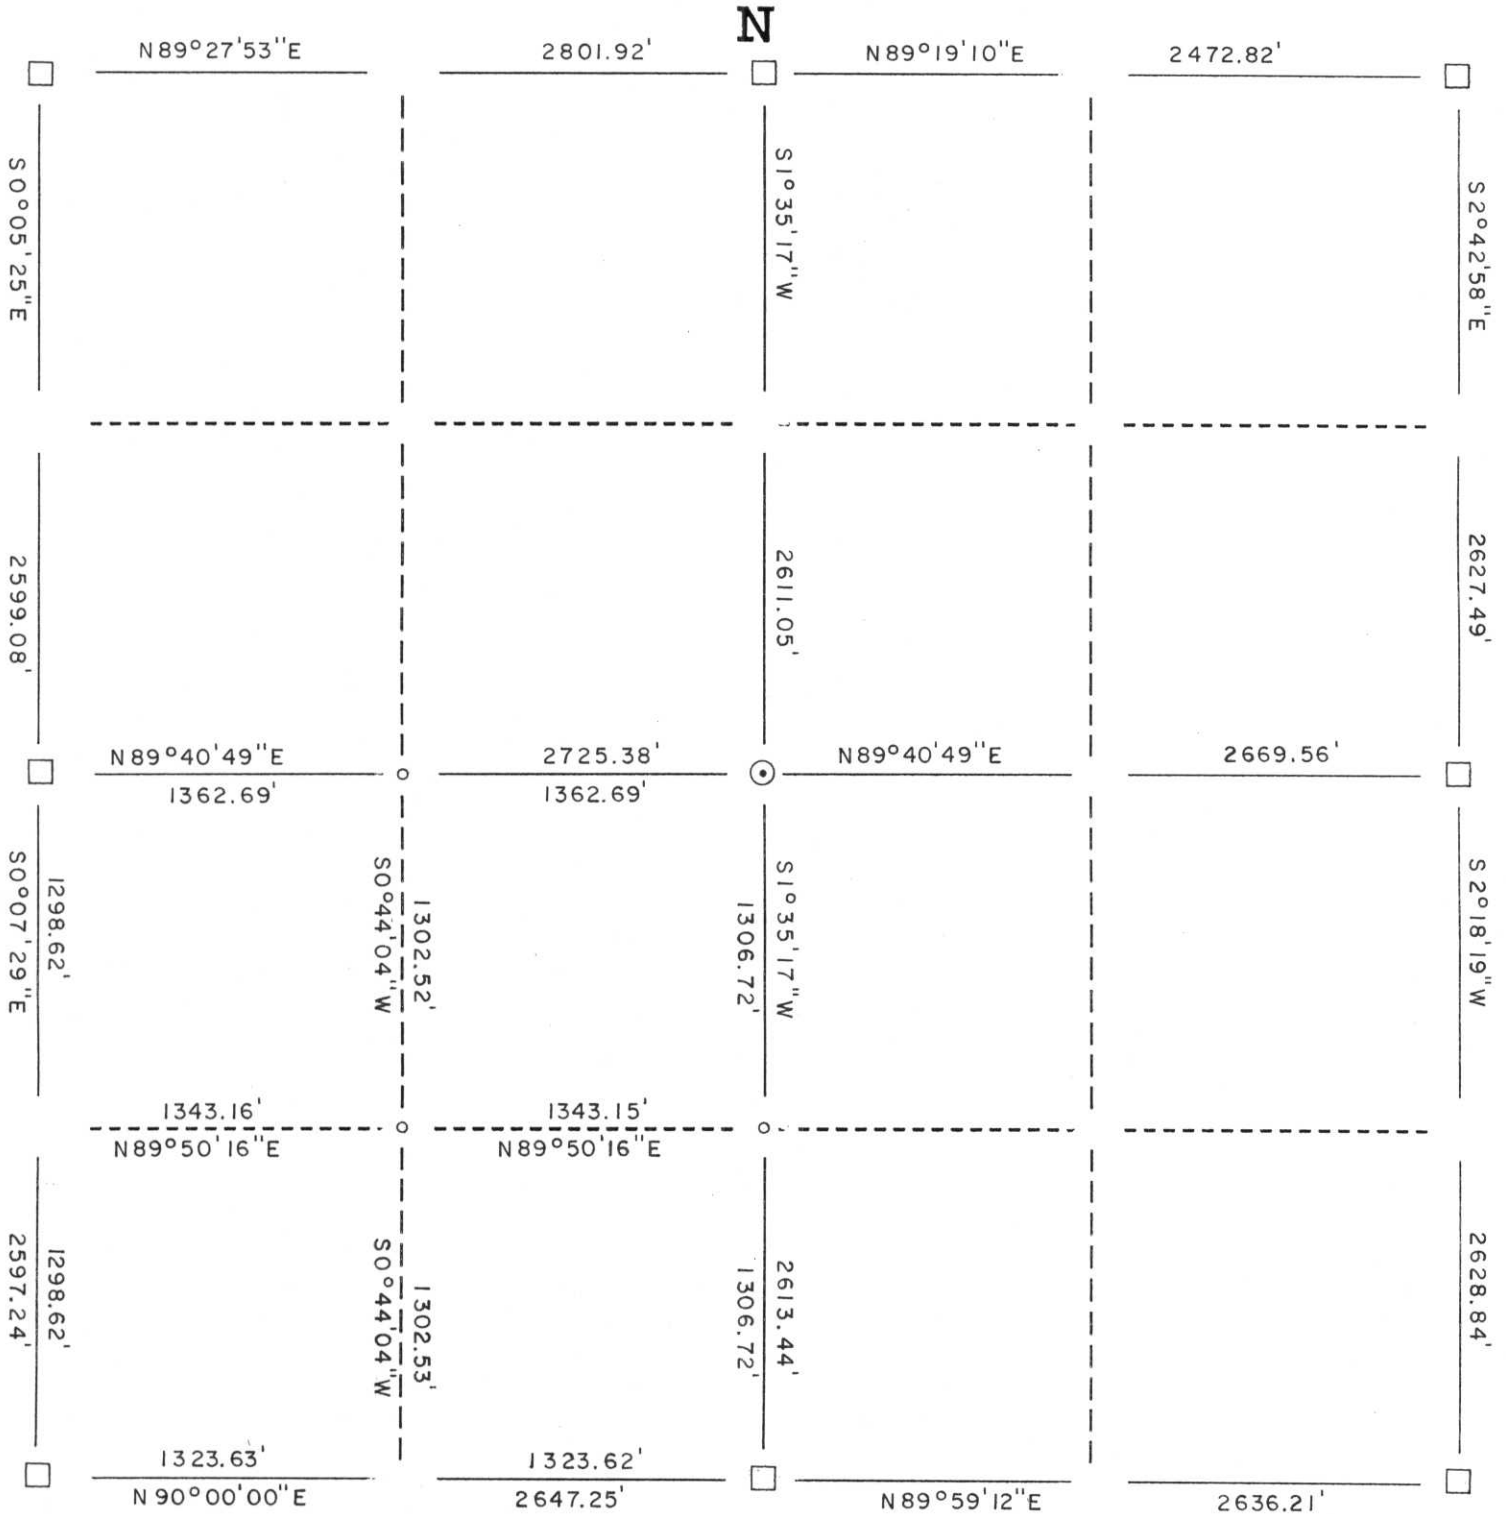

LEGEND

- Berntsen Monument
- 2" Iron Pipe
- Stone or Concrete Monument
- 1" Iron Pipe
- Iron Pipe
- Other
- SET 1 1/4" x 30" GEAR HEADED AXLE SHAFT
- SET 3/4" x 24" RE-BAR



RECEIVED BY LINCOLN COUNTY
SURVEYOR THIS 9TH DAY
OF January 20 06
Tony Walker
COUNTY SURVEYOR

CERTIFIED CORRECT:
David J. Goslin
DAVID J. GOSLIN S-2280

DATE: 1-9-06 Registered Land Surveyor

A.V.: 1221