


# Lincoln County Surveyor

SECTION SUMMARY 20 — 33 — 6  
 Section Township Range  
ROCK FALLS  
 Town

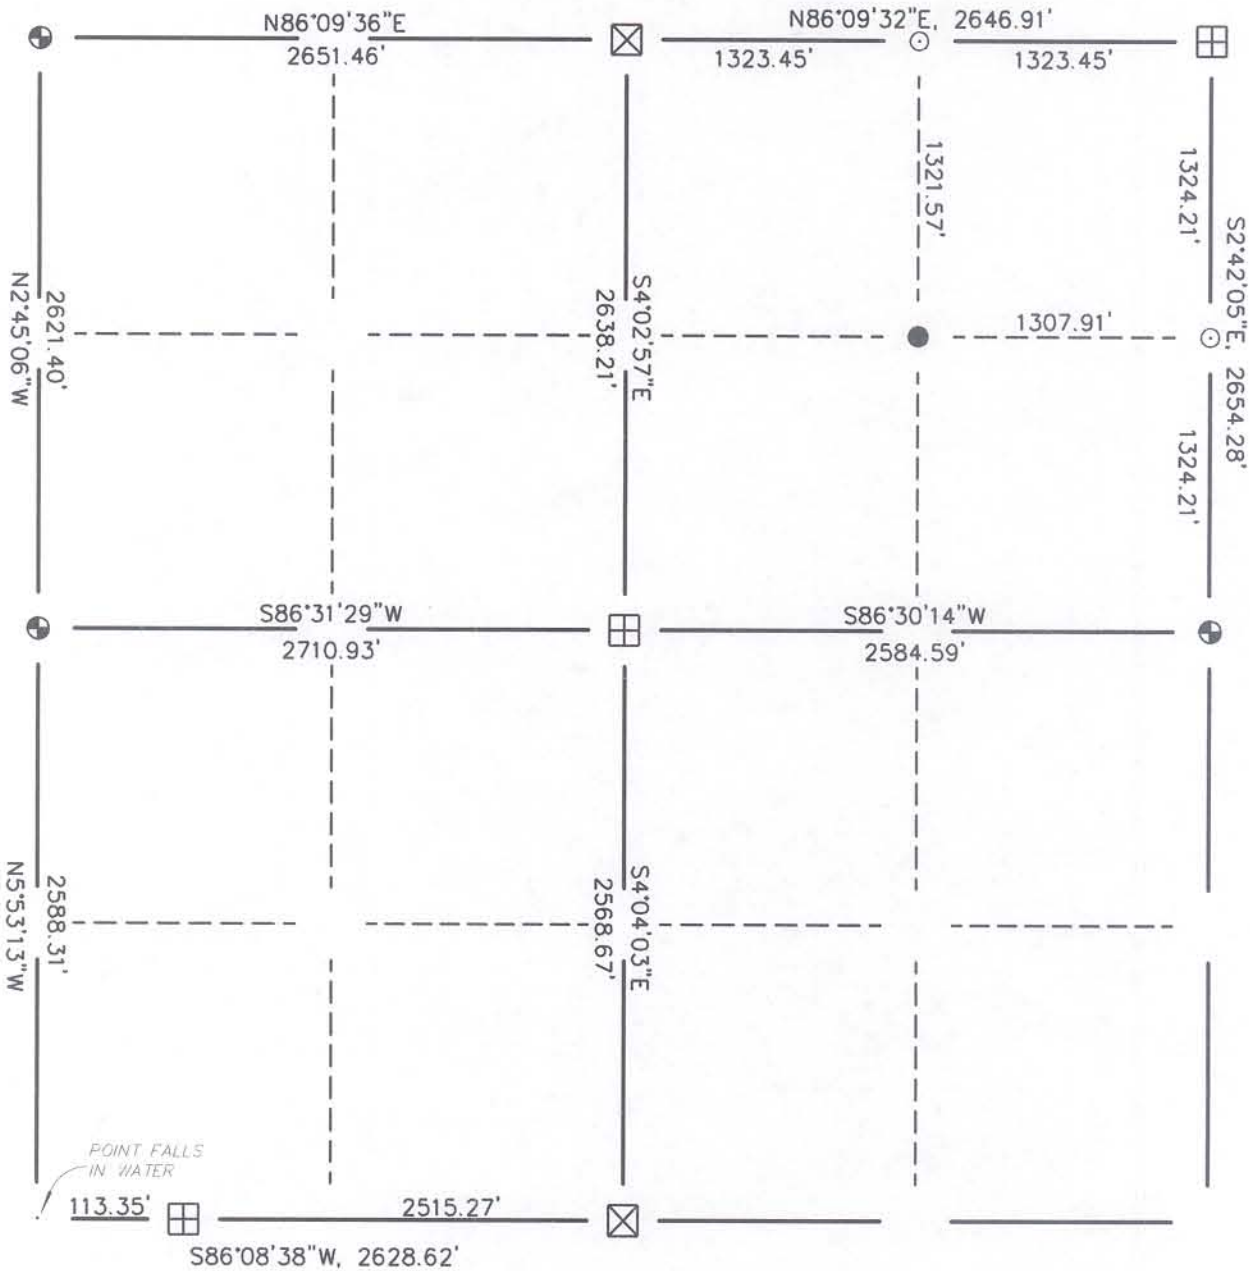

## LEGEND

- ⊕ - Berntsen Monument
- ⊞ - 6" x 6" Gray Granite Stone
- ⊞ - 6" x 6" Red Granite Stone
- ⊙ - 1-1/4" (od) Iron Pipe
- - 1" Aluminum Capped Iron Pipe



CERTIFIED CORRECT:

*William W. Nutter, RLS*

*William W. Nutter*  
 Registered Land Surveyor

DATE: 4-7-2004