




SECTION SUMMARY

N

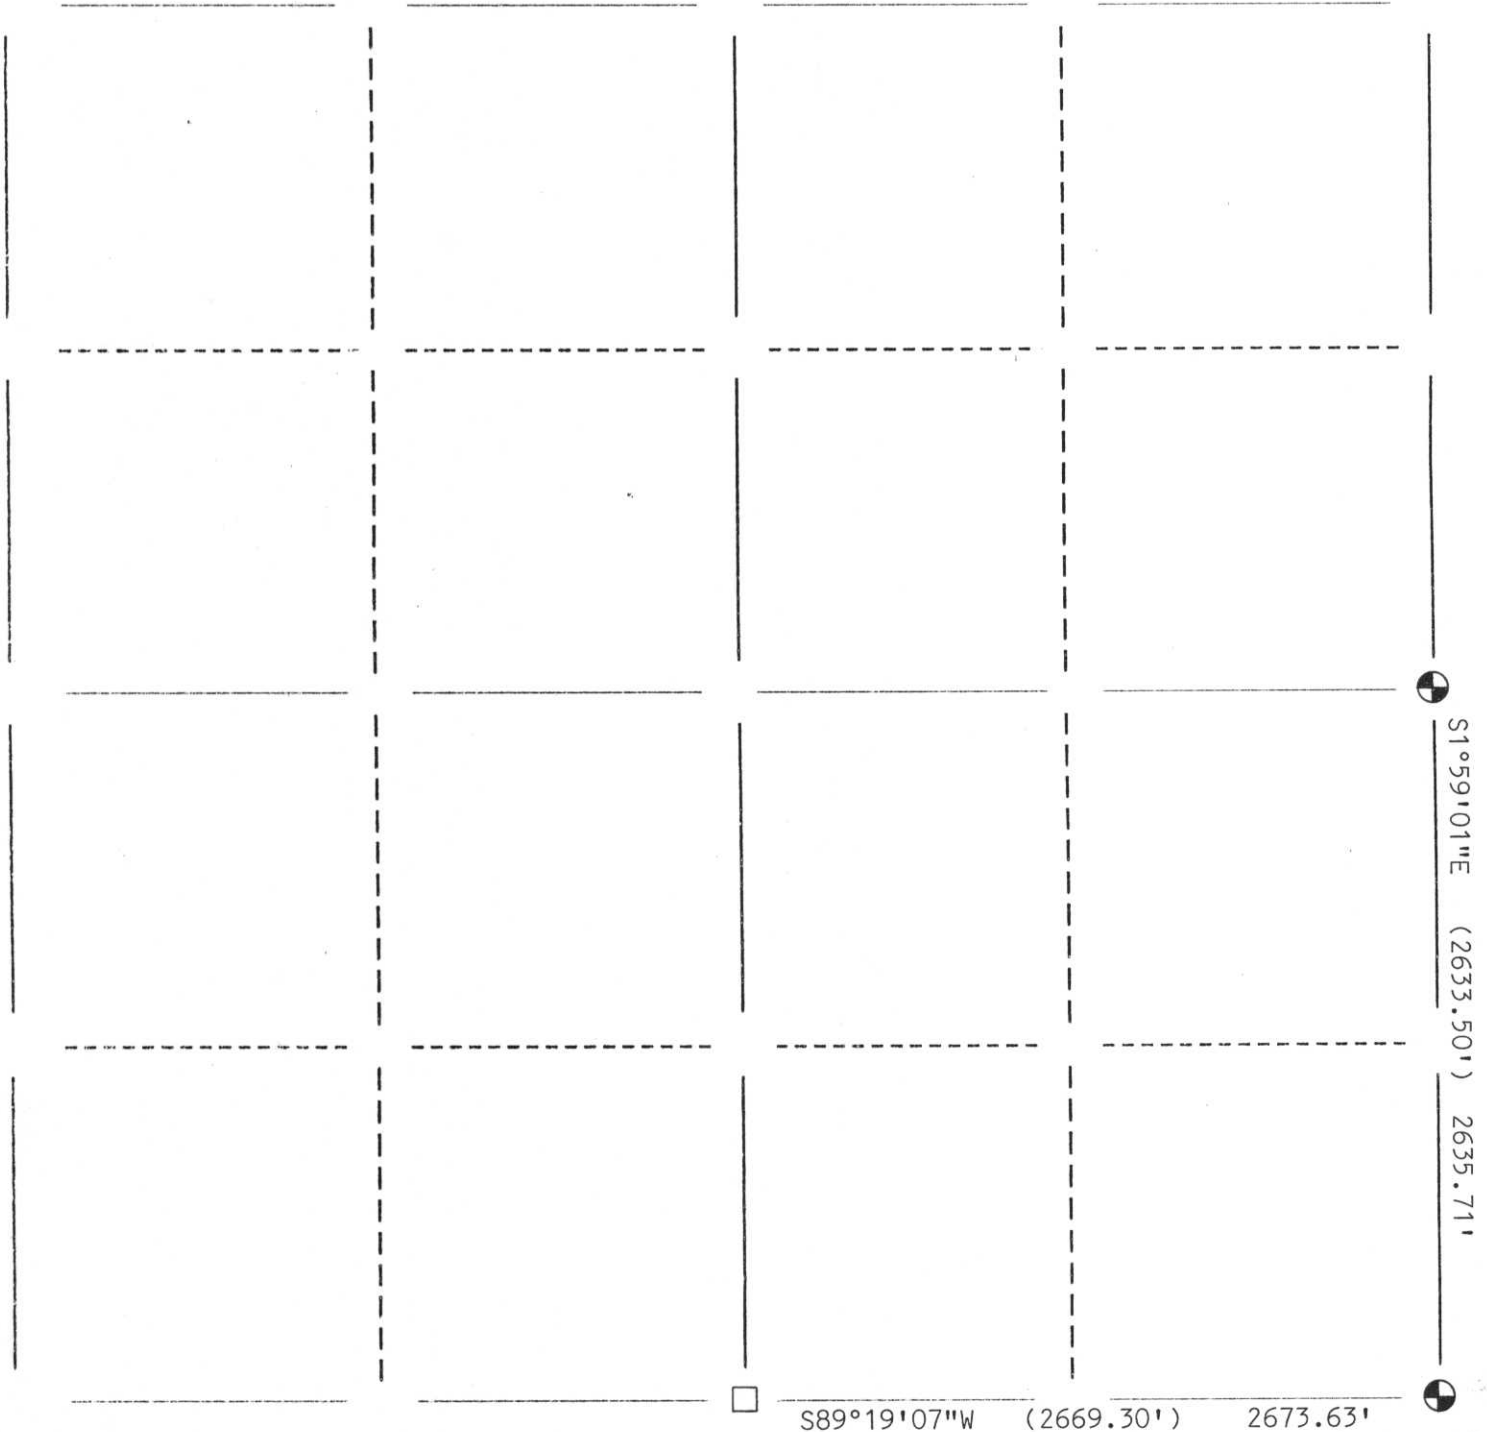

LEGEND

- Berntsen Monument
- 2" Iron Pipe
- Stone or Concrete Monument
- 1" Iron Pipe
- Iron Pipe
- Other



RECEIVED AT LINCOLN COUNTY
COURTHOUSE THIS 1st DAY
OF Feb 2000
Pat Priske
LAND INFORMATION OFFICE

CERTIFIED CORRECT:
David J. Goslin RLS No. 2280

David J. Goslin
Registered Land Surveyor

DATE: 1-28-00

() Record distance by Francis Fox

4:4-15:11