


LINCOLN COUNTY LAND CORNER MONUMENTS

T 33 N, R 6 E

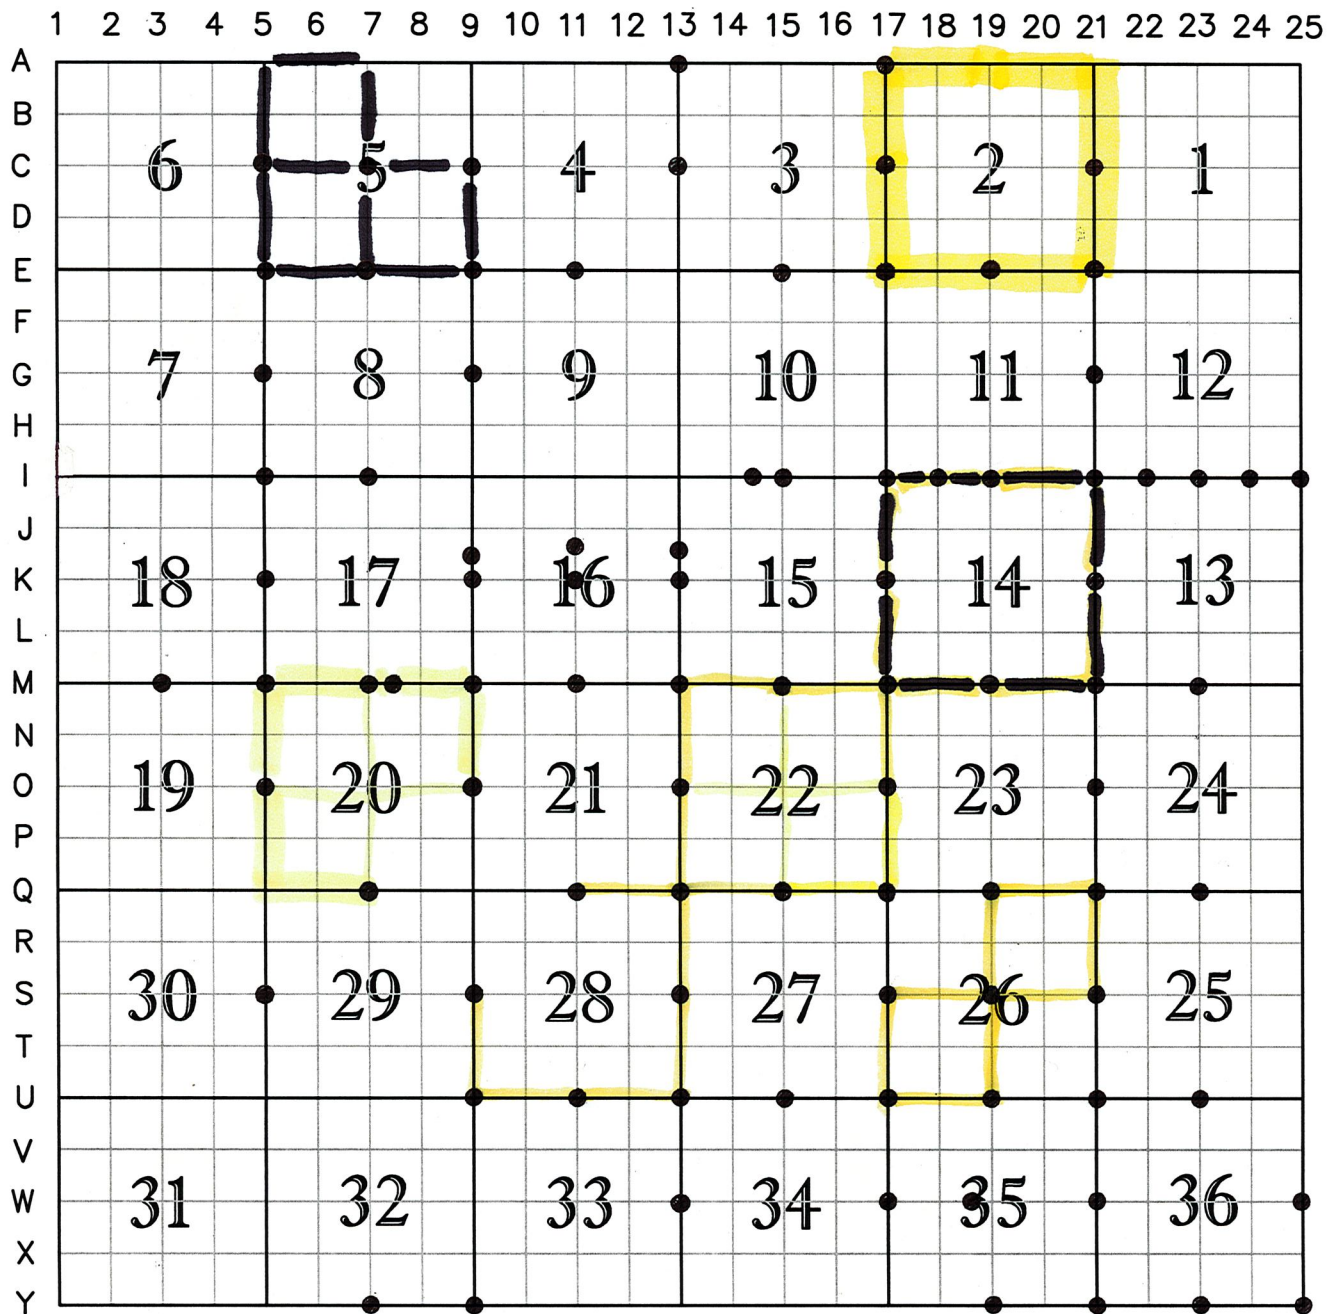

• = Corner monumented and record contained herein.

Corners such as meander corners which are not located at intersecting lines on the above diagram are identified by reference to adjoining applicable coordinate lines.

EX: AB-1, QR-19, S-18,19

T 33 N, R 6 E