


143.

DIAGRAM

OF
Township No. 33 North, Range No. 7
County, State of Wisconsin

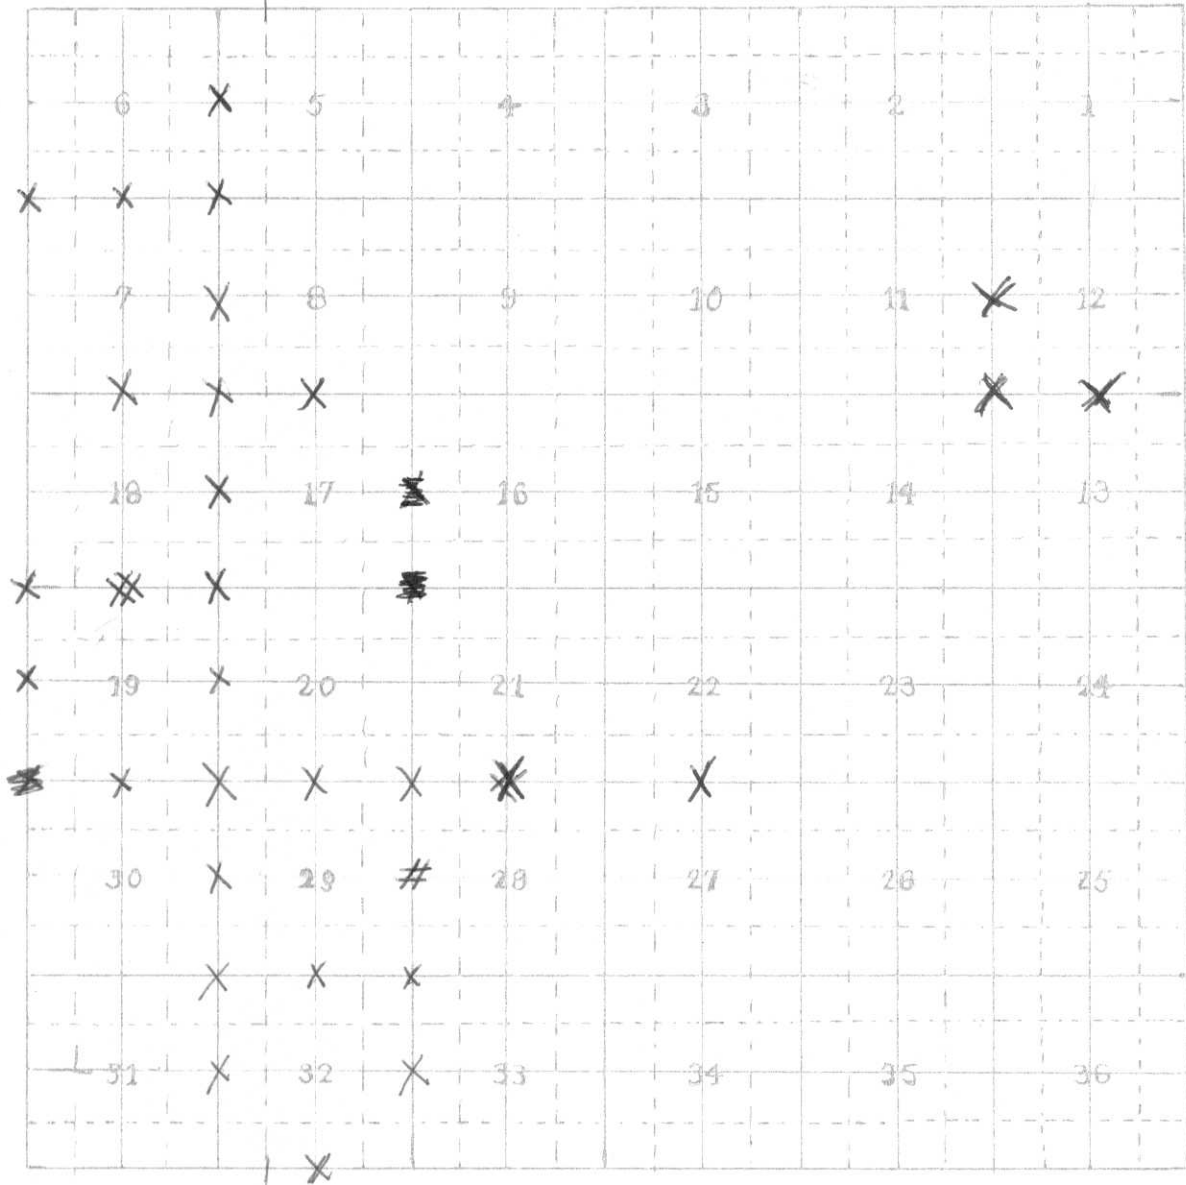

X-CORNER RESET
O-CORNER MISSING
#-CORNER FOUND

1922