

SECTION SUMMARY


BEING SECTION 8 & PART OF SECTION 5, TOWNSHIP 33 NORTH, RANGE 7 EAST, TOWN OF BIRCH, LINCOLN COUNTY, WI.

E 1/4 COR. SEC. 5-33-7
EXISTING GRANITE MONUMENT

5

192871.620
407347.540


PREPARED BY:
NORTHWOODS SURVEYING
623 JEFFERSON STREET
WAUSAU, WI. 54403
715-845-1249

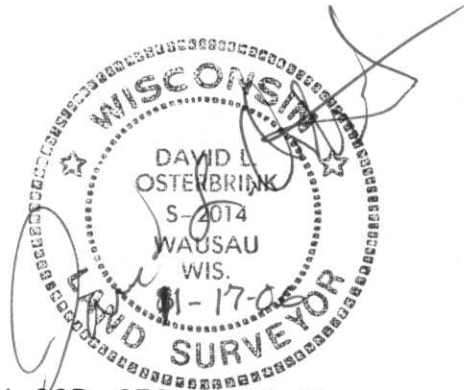

EXISTING PK NAIL
NOTE: ONE TIE REMAINS,
PK NAIL IS 0.1' OFF OF
TIE.

N 1/4 COR. SEC. 8-33-7
SET BERNTSEN MONUMENT
190229.004
404719.524

190243.098
407348.473

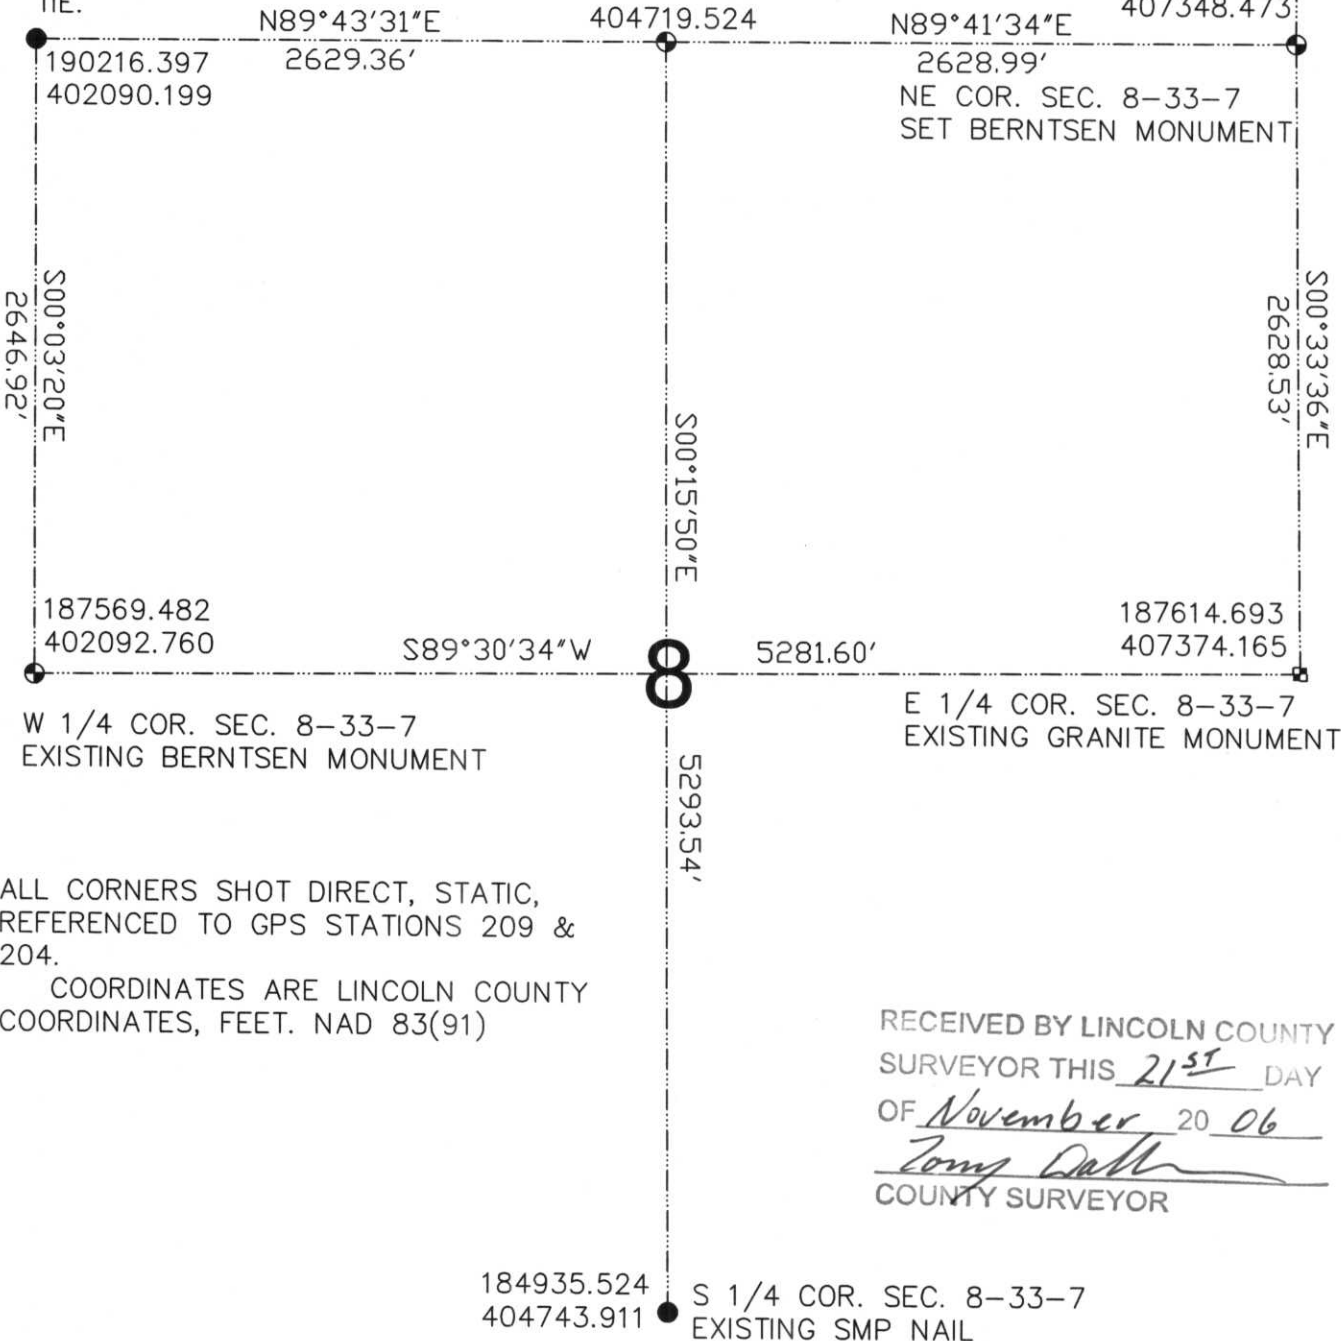

W 1/4 COR. SEC. 8-33-7
EXISTING BERNTSEN MONUMENT

E 1/4 COR. SEC. 8-33-7
EXISTING GRANITE MONUMENT

ALL CORNERS SHOT DIRECT, STATIC,
REFERENCED TO GPS STATIONS 209 &
204.

COORDINATES ARE LINCOLN COUNTY
COORDINATES, FEET. NAD 83(91)

RECEIVED BY LINCOLN COUNTY
SURVEYOR THIS 21ST DAY
OF November 20 06
Tom Dalt
COUNTY SURVEYOR