


SECTION SUMMARY / INDEX

19 - 33 - 7
SECTION TOWN RANGE

BIRCH
TOWNSHIP

M-Q: 1-5

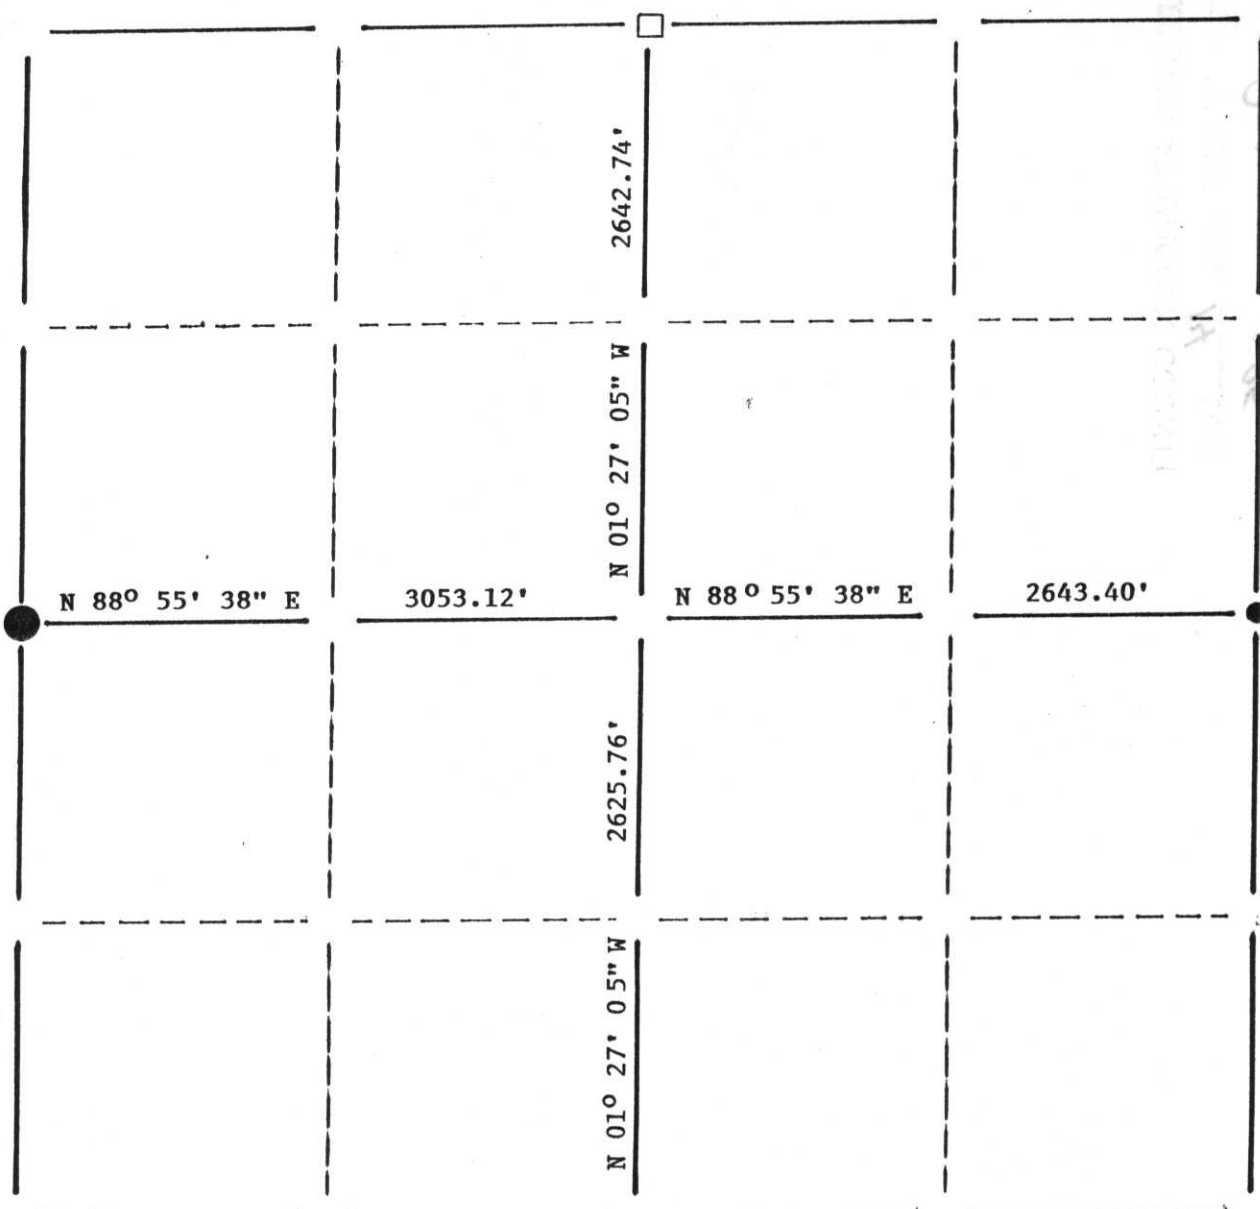

LEGEND

Nothing Set
(C/L Hwy "51")

- ⊕ - HARRISON CAST IRON MONUMENT
- - STONE OR CONCRETE MONUMENT
- - 2" IRON PIPE
- - 1" IRON PIPE
- - IRON BAR 7/8" x 30" with Cap
- △ - R.R. SPIKE
- - PK NAIL
- - BERNTSEN MONUMENT
- ▲ - OTHER - _____

LHM SURVEYING

4203 SCHOFIELD AVE, SCHOFIELD, WI. 54476