


**Lincoln
County
Surveyor**

SECTION SUMMARY 22 — 33 — 7
 Section Township Range
BIRCH
 Town

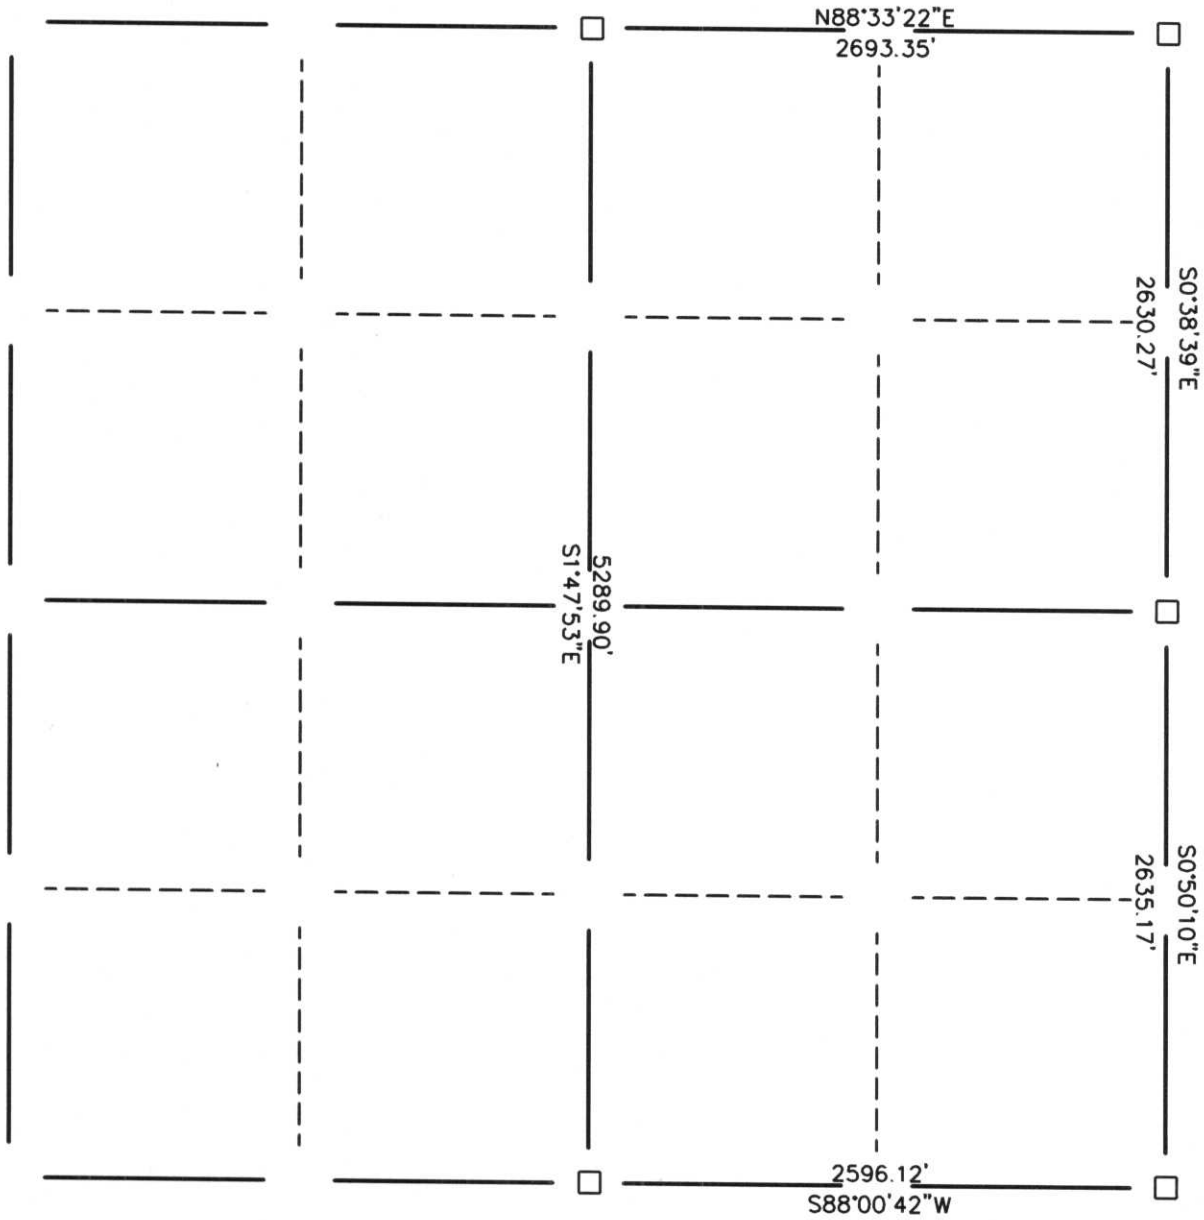

LEGEND

- ⊕ - Berntsen Monument
- - Stone or Concrete Monument
- - 2" Iron Pipe
- - 1" Iron Pipe
- - Iron Bar
- ⊙ - 1"x 48" Swamp Rod with Lincoln County Cap

CERTIFIED CORRECT:

William W. Nutter, RLS

William W. Nutter
 Registered Land Surveyor

DATE: 4-5-2002

RECEIVED AT LINCOLN COUNTY
 COURTHOUSE THIS 9TH DAY
 OF April 20 02
Tony Dalko
 LAND INFORMATION OFFICE



M-Q: 13-17