


LINCOLN COUNTY

SECTION SUMMARY

29 - 33 - 7
Section Town Range

BIRCH

Township

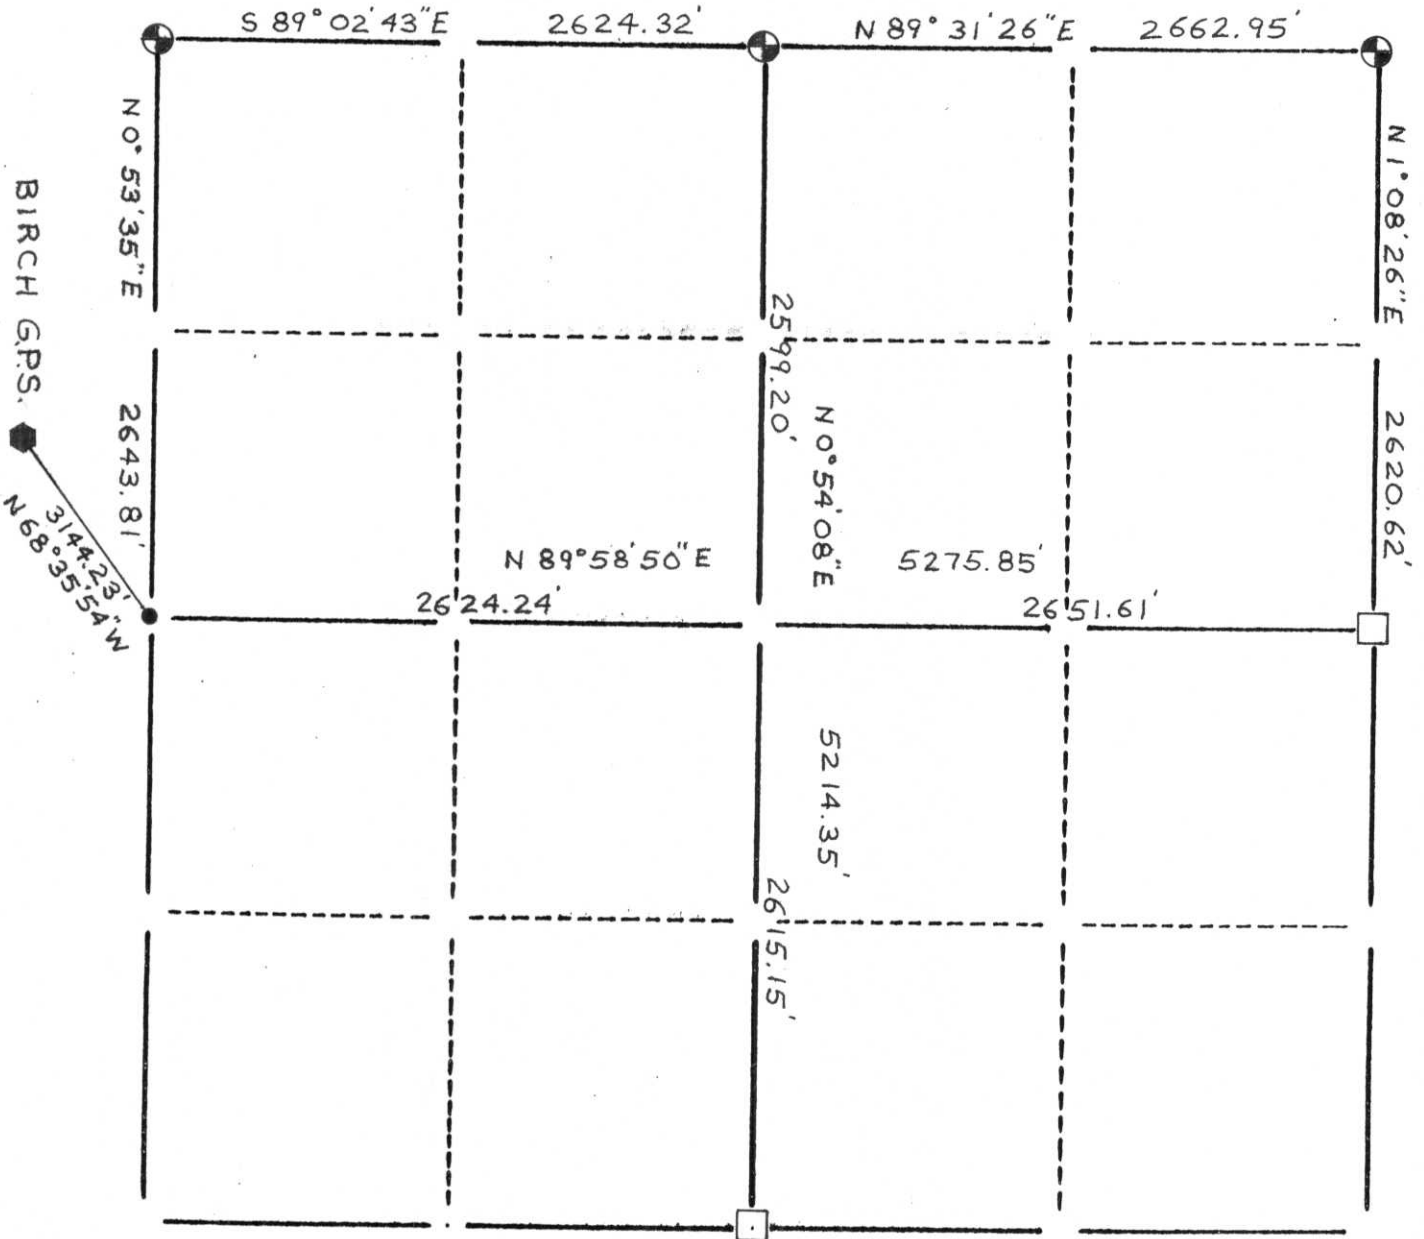

LEGEND

- ⊕ - Harrison Cast Iron Monument, BERNTSEN
- - Stone or Concrete Monument
- - 2" Iron Pipe
- - 1" Iron Pipe
- - Iron Bar
- Other

SEAL



CERTIFIED CORRECT:

Edwin R. Abendroth

S-798

Registered Land Surveyor

DATE: *May 15, 1997*

RECEIVED AT LINCOLN COUNTY
 COURTHOUSE THIS 15th DAY
 OF May 1997
Pat Pribe
 TAX DESCRIPTION OFFICE

Q-U: 5-9