




SECTION
SUMMARY

10 - T33N - R8E
Section Township Range
RUSSELL
Town

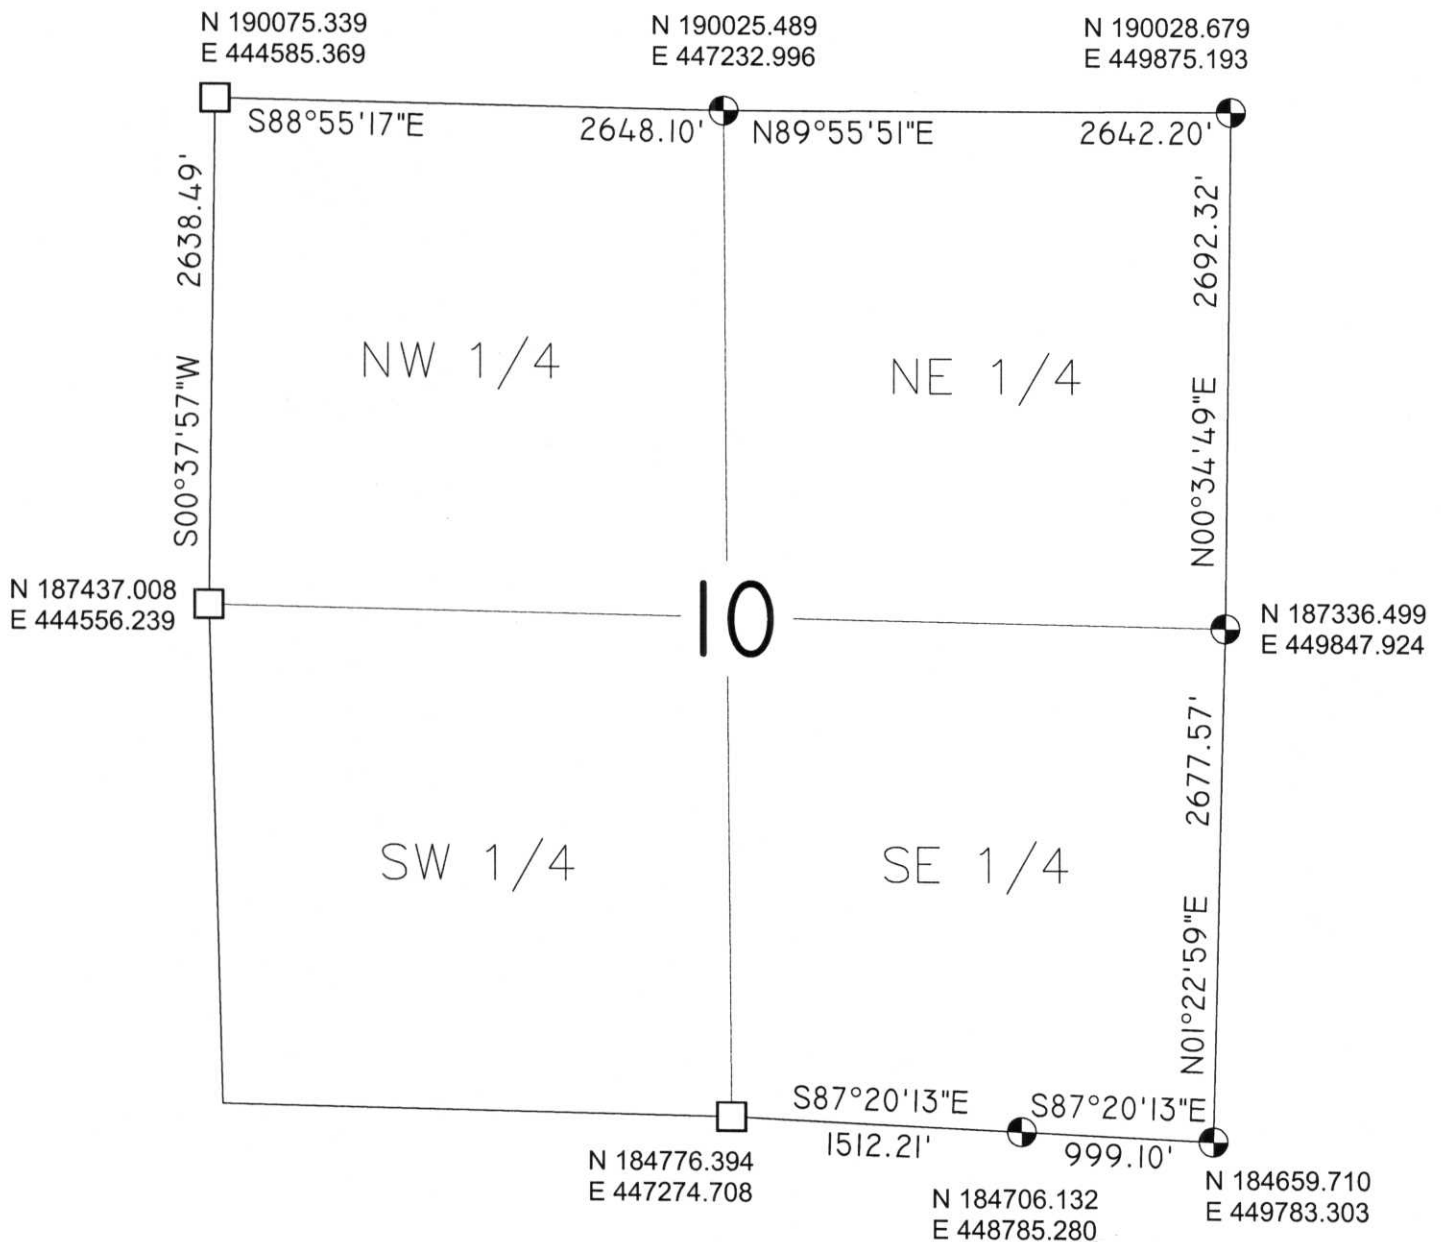

NOTES:

1-COORDINATES & BEARINGS BASED ON LINCOLN COUNTY COORDINATE SYSTEM.

LEGEND

- BERNSTEN MONUMENT
- GRANITE STONE
- 1 1/2" IRON PIPE
- 2" IRON PIPE
- PK NAIL
- RR SPIKE
- LOCATION FROM TIES
- 3/4" REBAR
- SWAMP ROD

RECEIVED BY LINCOLN COUNTY
SURVEYOR THIS 11TH DAY
OF January 20 05
Tomy Dall
COUNTY SURVEYOR


CERTIFIED CORRECT:

DAVID A. RENAUD

David Renaud S-2142
Registered Land Surveyor

DATE: 12-23-04

R.E.I. 4080 N. 20th AVE WAUSAU, WI 54401 (715)675-9784

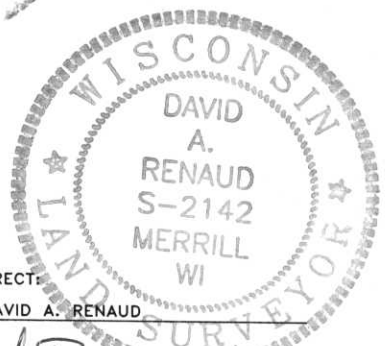

E-I, 13-17