


PRIVATE 0200 IMPAGE SALE

OWENS-ILLINOIS

DATE 10/29/73

T. 33 N R. 8 E SEC. 13

LINCOLN COUNTY, WIS.

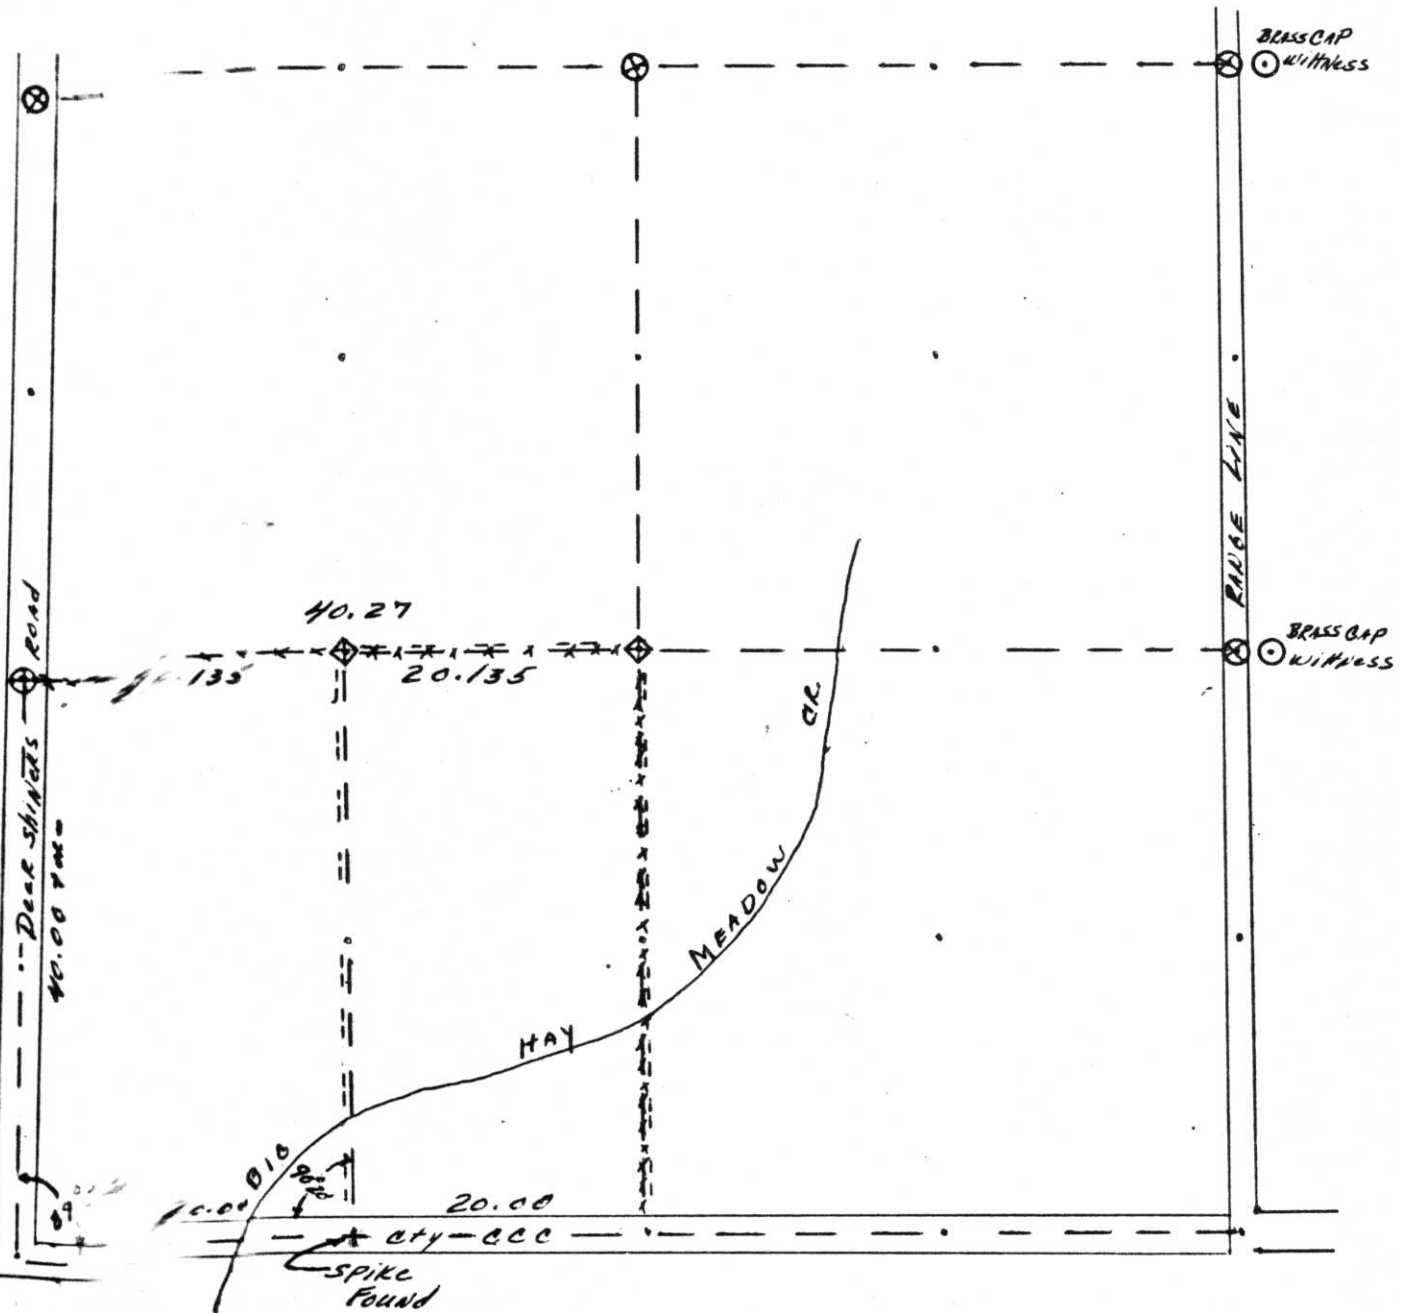

LEGEND AND CORNERS & LINES

- ⊙ 1 1/2" Pipe or Cap
- ⊗ Concrete
- ⊕ Wood Post
- ⊖ Spike
- △ Spike
- X Spike
- + Spike

- ===== True - Blazed - Painted
- True Cut - Blazed
- Approximate - Painted
- Random
- xxxxx Fence
- . - R. O. W.

MAP BY
Dean Pelkey

Scale 1 1/2" = 1320.0'

I-M: 21,25