




SECTION SUMMARY

18 - T33N - R8E
 Section Township Range
 RUSSELL
 Town

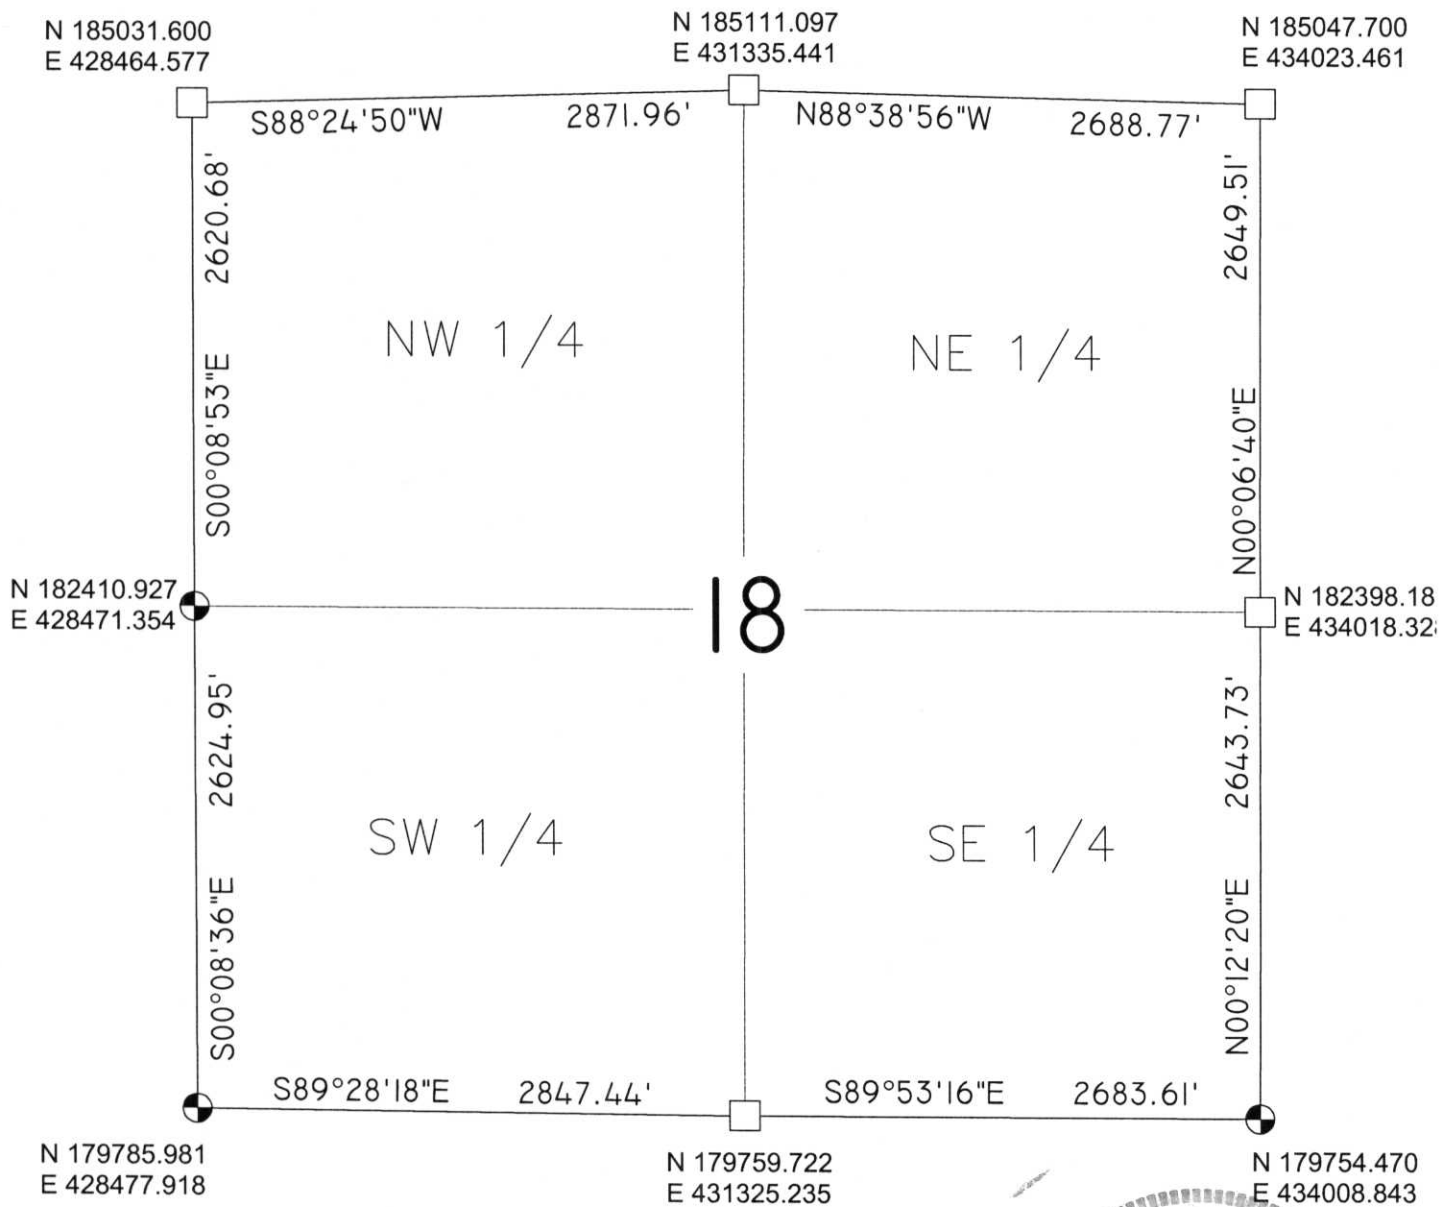


NOTES:
 1-COORDINATES & BEARINGS BASED ON LINCOLN COUNTY COORDINATE SYSTEM.

LEGEND

- ⊕ -BERNSTEN MONUMENT
- -GRANITE STONE
- -1 1/2" IRON PIPE
- -2" IRON PIPE
- △ -PK NAIL
- ▲ -RR SPIKE
- -LOCATION FROM TIES
- ⊙ -3/4" REBAR


RECEIVED BY LINCOLN COUNTY SURVEYOR THIS 11TH DAY OF January 20 05
Zany Dalk
 COUNTY SURVEYOR

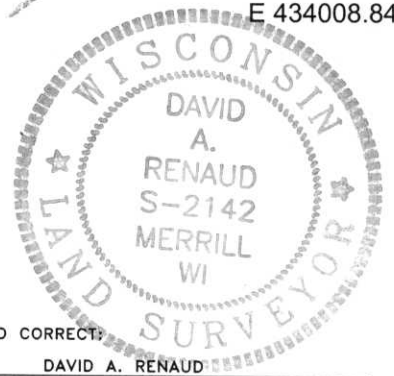

CERTIFIED CORRECT
 DAVID A. RENAUD


David Renaud S-2142
 Registered Land Surveyor

DATE: 12-23-04

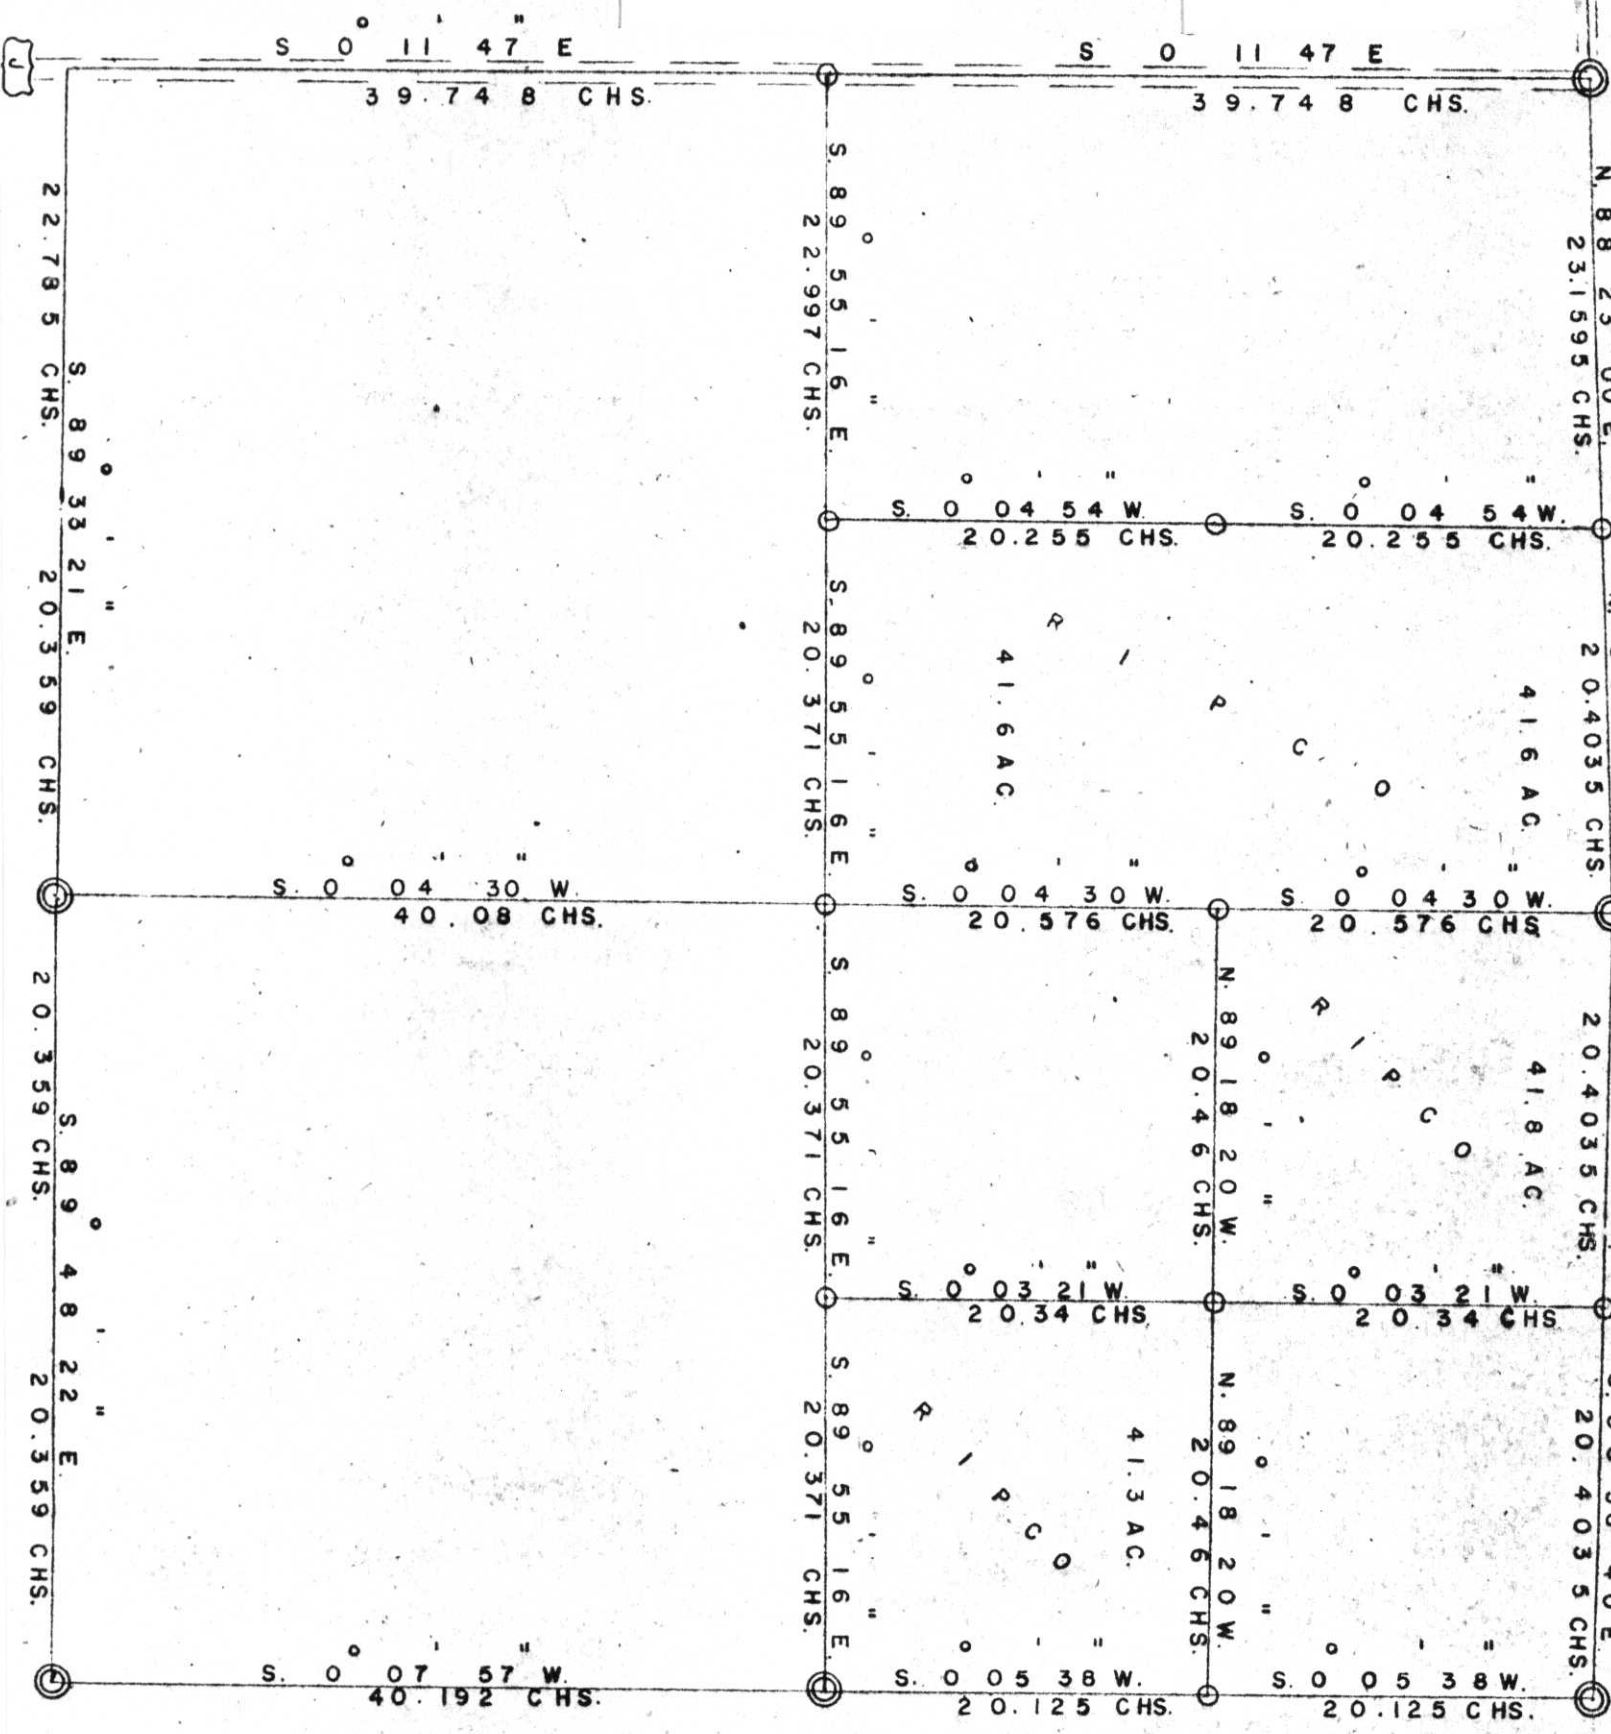

S18
S17

I-M: 1, 5

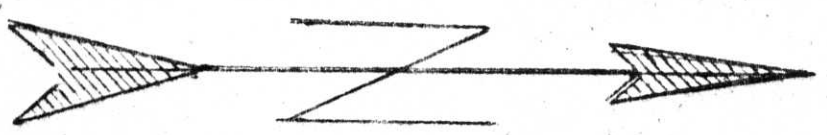

RESURVEY OF

11N