




SECTION  
SUMMARY

28 - T33N - R8E  
Section Township Range  
RUSSELL  
Town

N 174484.987  
E 439222.507

N 174254.917  
E 444600.471

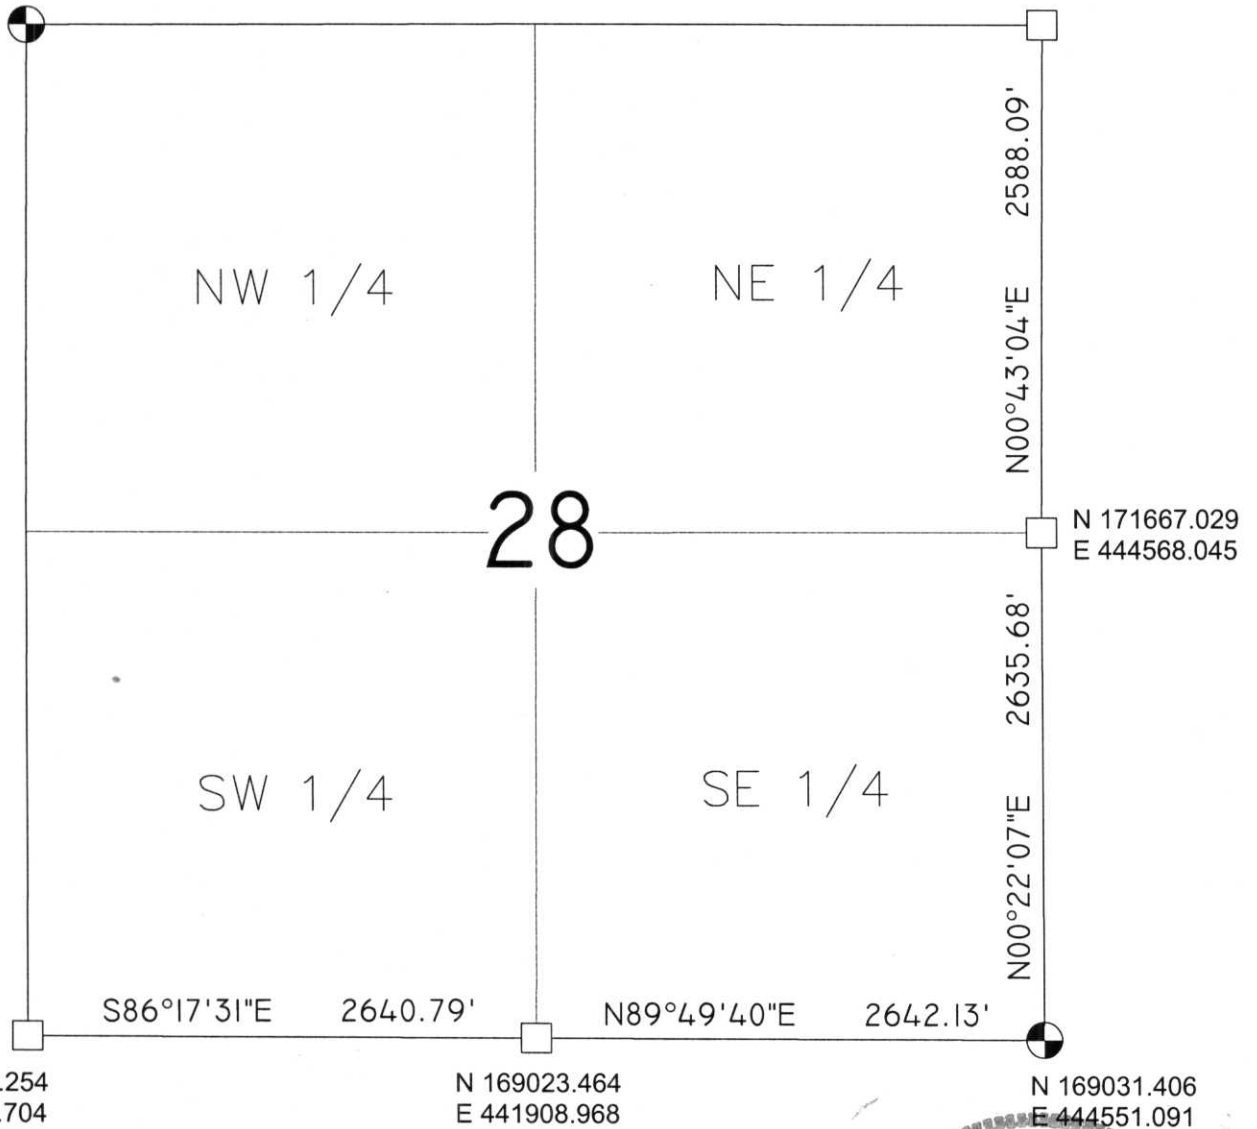


NOTES:  
1-COORDINATES & BEARINGS BASED ON LINCOLN COUNTY COORDINATE SYSTEM.

**LEGEND**

- ⊕ -BERNSTEN MONUMENT
- -GRANITE STONE
- -1 1/2" IRON PIPE
- -2" IRON PIPE
- △ -PK NAIL
- ▲ -RR SPIKE
- -LOCATION FROM TIES
- ⊙ -3/4" REBAR

RECEIVED BY LINCOLN COUNTY  
SURVEYOR THIS 11<sup>TH</sup> DAY  
OF January 20 05  
Tony Dalt  
COUNTY SURVEYOR

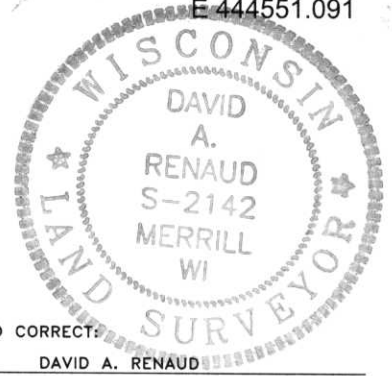

CERTIFIED CORRECT

DAVID A. RENAUD

David Renaud S-2142  
Registered Land Surveyor

DATE: 12-23-04

Q-01 9-13