




SECTION  
SUMMARY

30 - T33N - R8E  
Section Township Range  
RUSSELL  
Town

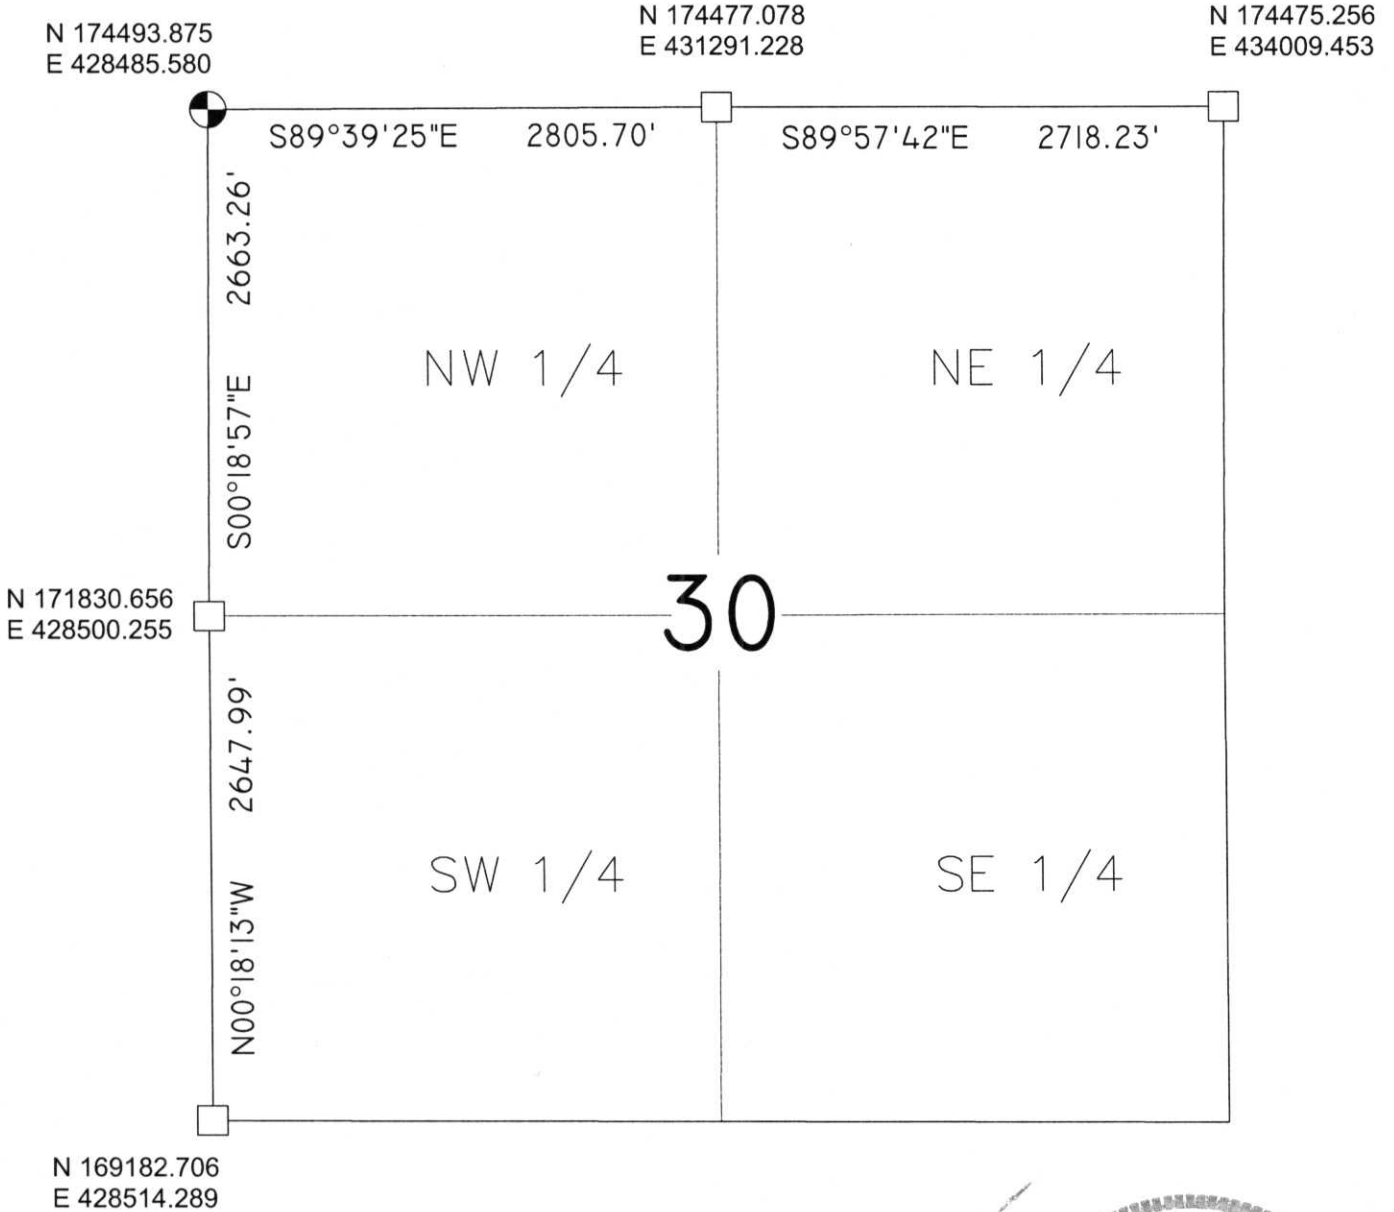

NOTES:  
1-COORDINATES & BEARINGS BASED ON LINCOLN COUNTY COORDINATE SYSTEM.

LEGEND

- -BERNSTEN MONUMENT
- -GRANITE STONE
- -1 1/2" IRON PIPE
- -2" IRON PIPE
- △ -PK NAIL
- ▲ -RR SPIKE
- -LOCATION FROM TIES
- -3/4" REBAR

RECEIVED BY LINCOLN COUNTY  
SURVEYOR THIS 11<sup>TH</sup> DAY  
OF January 20 05  
Jerry Dahl  
COUNTY SURVEYOR



CERTIFIED CORRECT:  
DAVID A. RENAUD

David Renaud S-2142  
Registered Land Surveyor

DATE: 12-23-04