


# Lincoln County Surveyor


SECTION 35 — 33 — 8  
 SUMMARY Section Township Range  
RUSSELL  
 Town

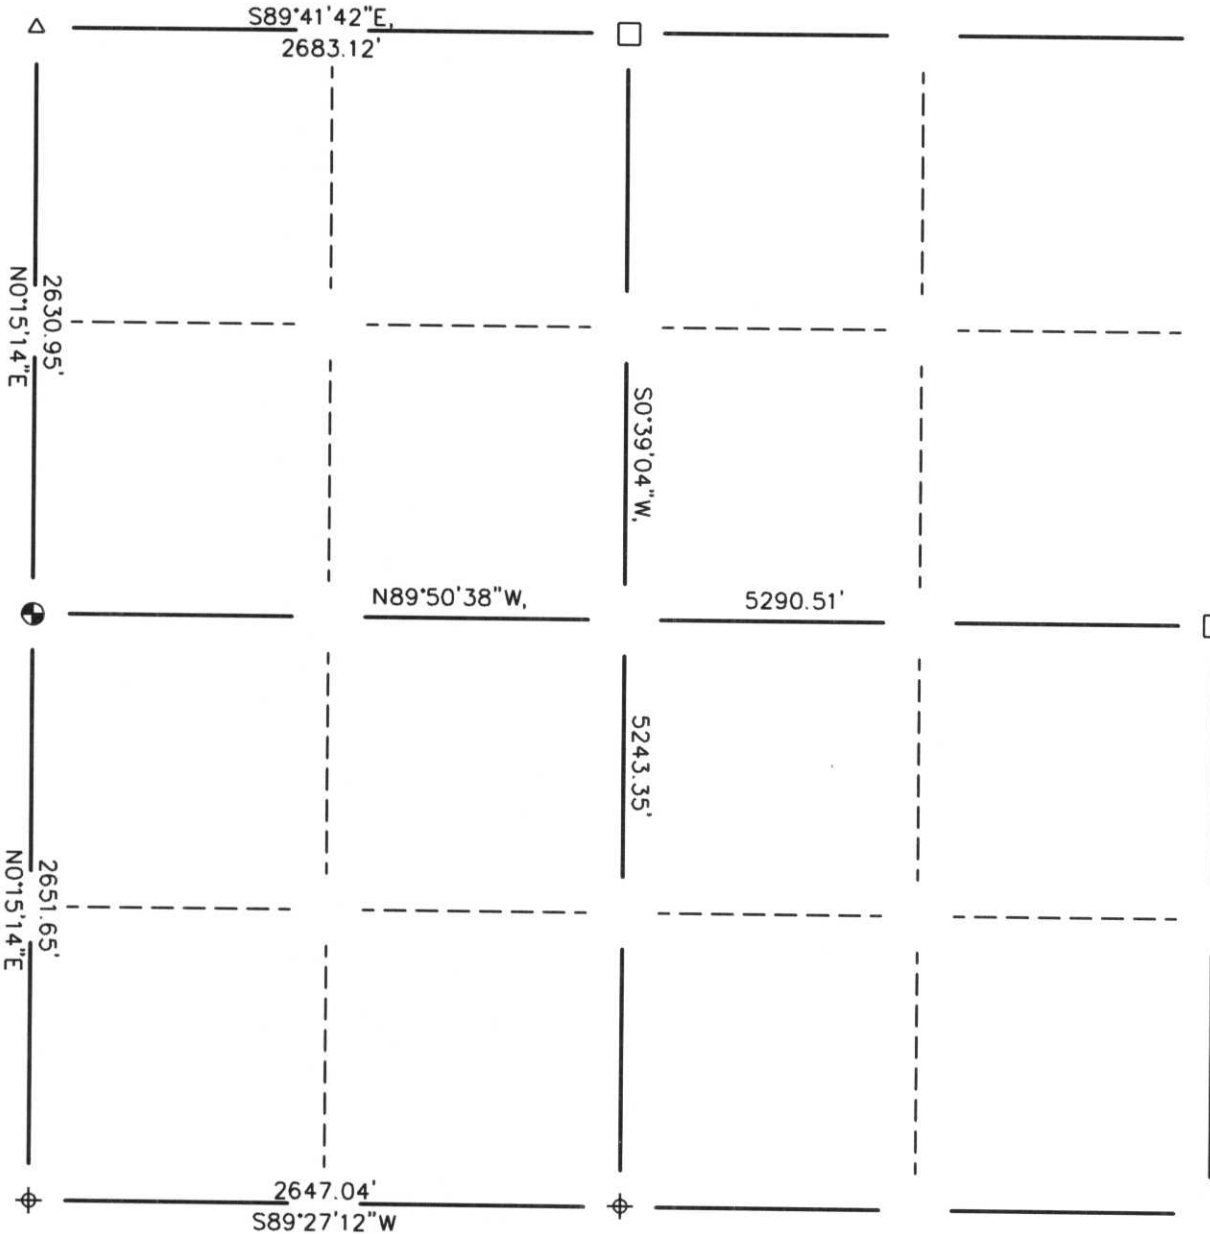

### LEGEND

- ⊕ - Berntsen Monument
- - 8" x 8" Red Granite Stone
- △ - Horse Nail
- ⊕ - SN-1 Nail

RECEIVED AT LINCOLN COUNTY  
 COURTHOUSE THIS 4<sup>TH</sup> DAY  
 OF November 20 02  
*Tommy Hall*  
 LAND INFORMATION OFFICE

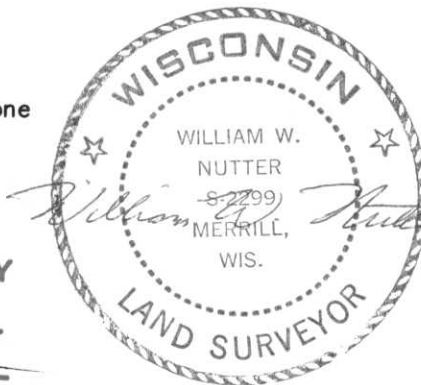

CERTIFIED CORRECT:  
*William W. Nutter, RLS*  
 Registered Land Surveyor  
 DATE: 11-1-2002

0-9:12, 21