


Lincoln County Section Summary




Section 1, T 34 N, R 4 E

Tomahawk Township

Lincoln County, Wisconsin

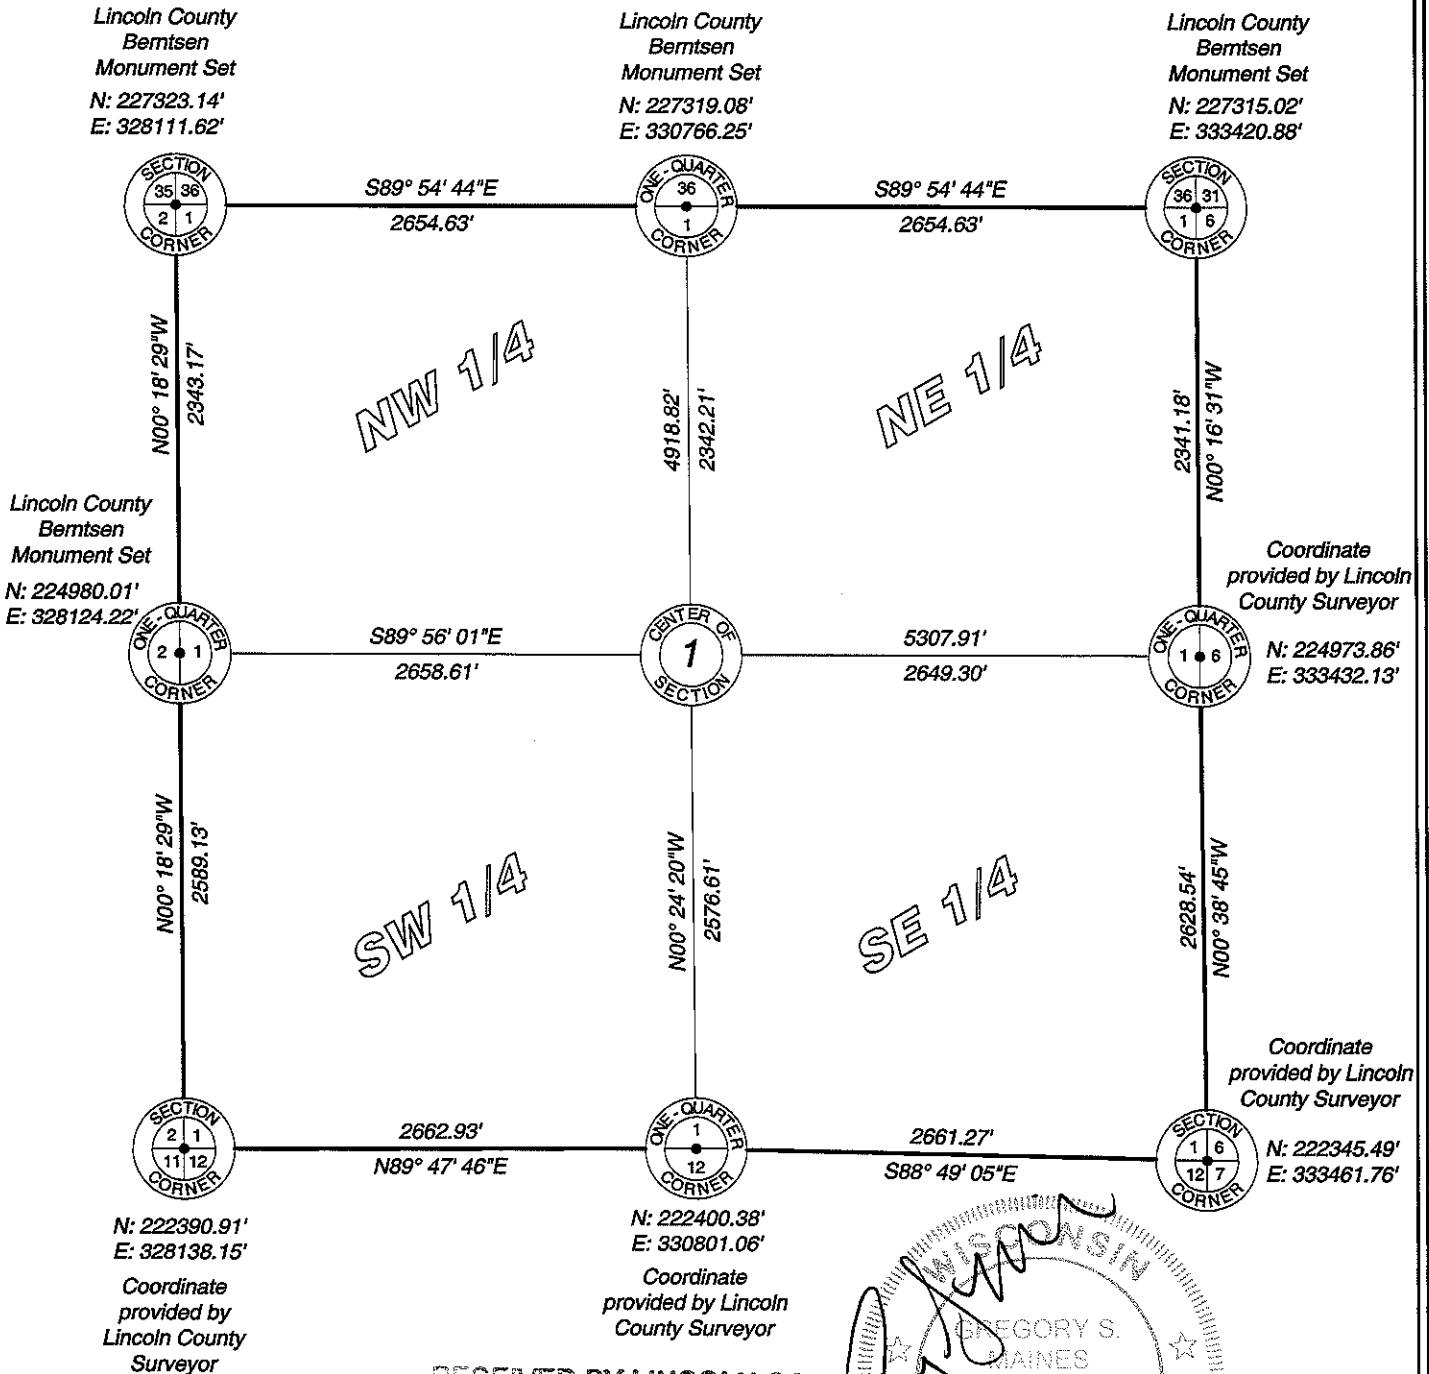

Lincoln County Grid
 RECEIVED BY LINCOLN COUNTY SURVEYOR THIS 21ST DAY OF December 20 12
Tom Dallen
 COUNTY SURVEYOR

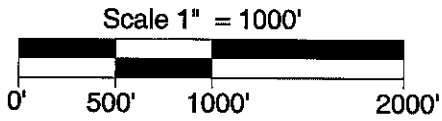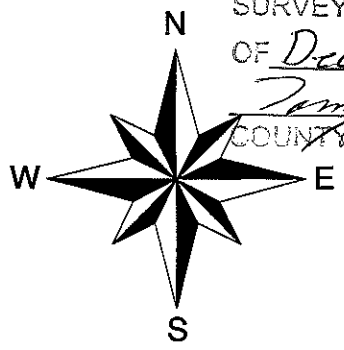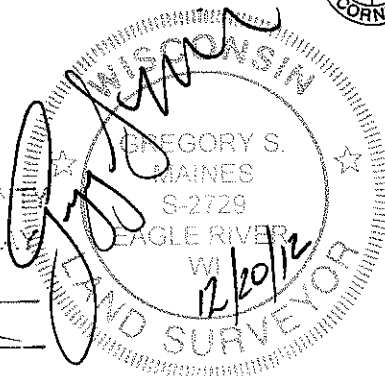

I hereby certify that the information shown hereon is true and correct to the best of my knowledge and belief.

5230 Highway 70 West
 Eagle River, WI 54521
 Phone 715.479.2570
 Fax 715.479.7274
 mainesandassociates.com

Sec 1