

# Lincoln County Section Summary

## Section 10, T 34 N, R 4 E


### Tomahawk Township

### Lincoln County, Wisconsin

Coordinate provided by Lincoln County Surveyor  
 N: 221971.93'  
 E: 317647.20'



Coordinate provided by Lincoln County Surveyor  
 N: 222028.95'  
 E: 320269.50'

Coordinate provided by Lincoln County Surveyor  
 N: 222086.87'  
 E: 322893.58'

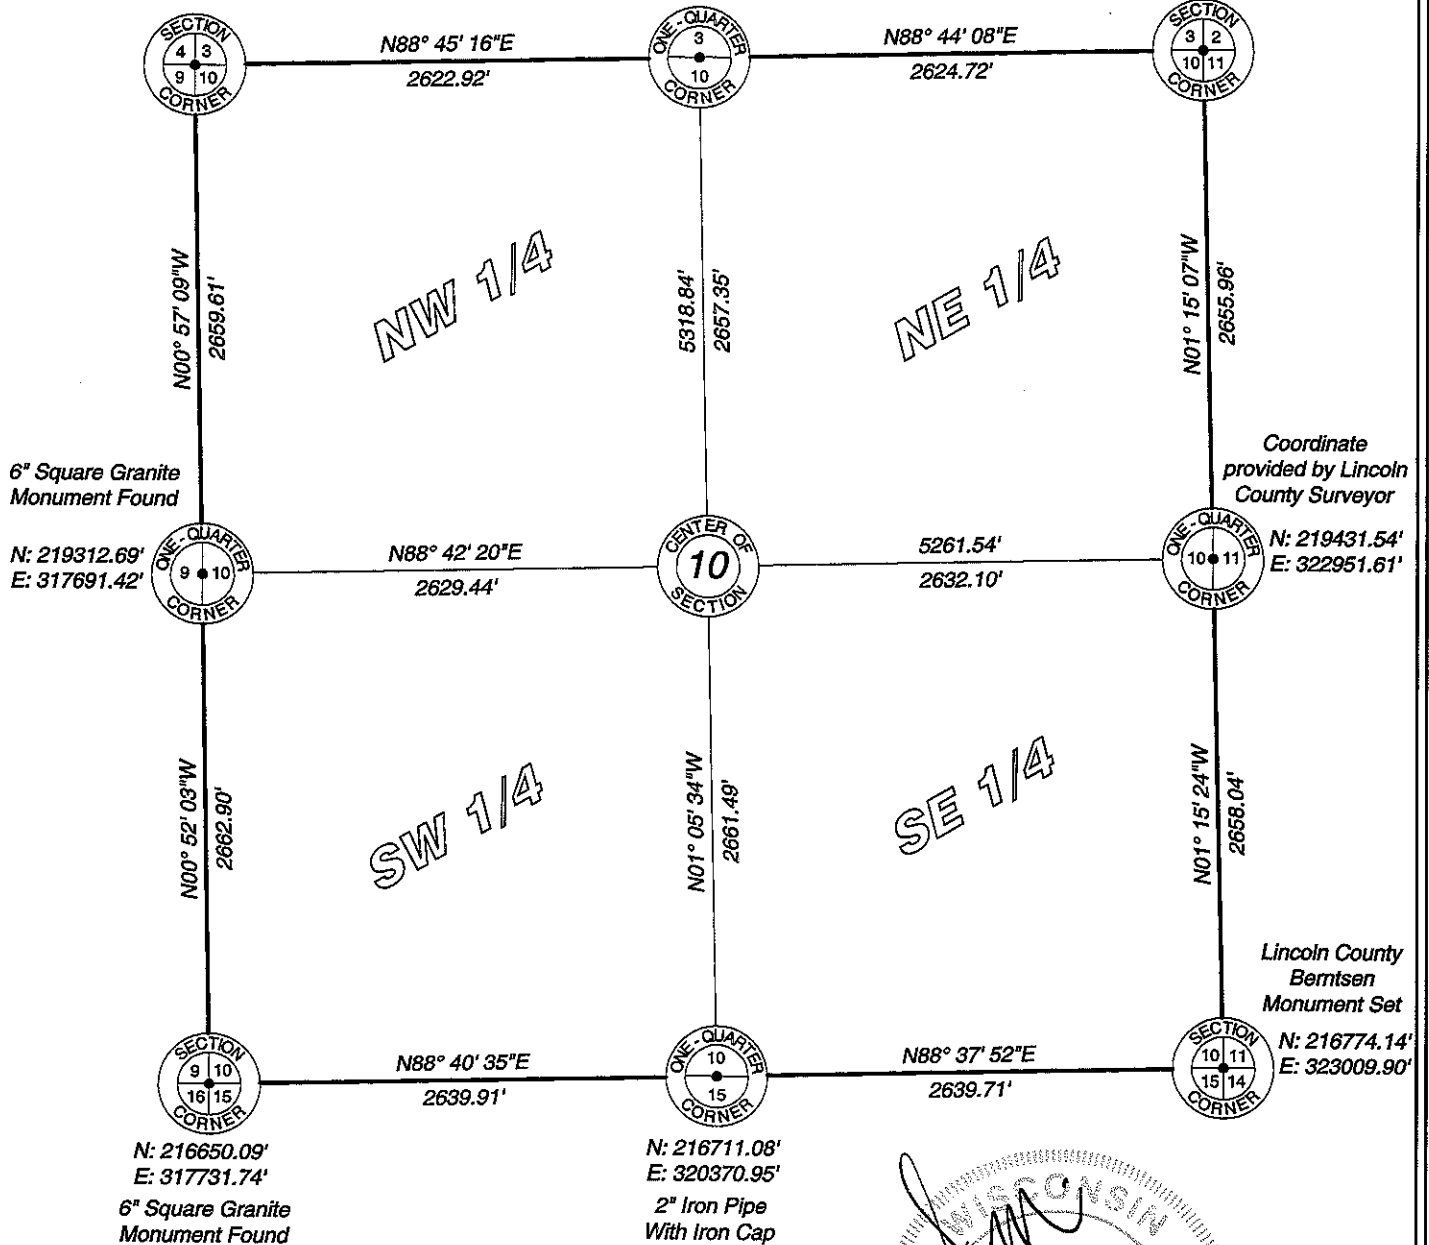


Lincoln County

RECEIVED BY LINCOLN COUNTY SURVEYOR THIS 21<sup>ST</sup> DAY OF December 20 12  
 [Signature]  
 COUNTY SURVEYOR

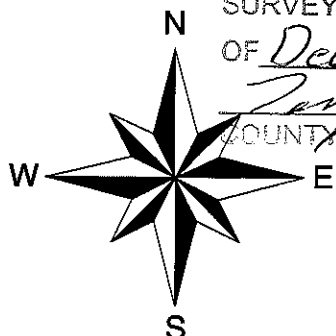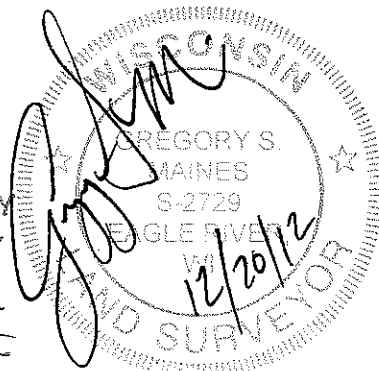

Scale 1" = 1000'

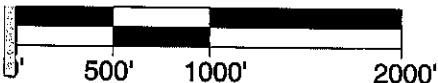

I hereby certify that the information shown hereon is true and correct to the best of my knowledge and belief.



5230 Highway 70 West  
 Eagle River, WI 54521

Phone 715.479.2570  
 Fax 715.479.7274

**MAINES & ASSOCIATES**  
 Land Surveyors

mainesandassociates.com

Sec 10