


Lincoln County Section Summary

Section 16, T 34 N, R 4 E

Tomahawk Township

Lincoln County, Wisconsin

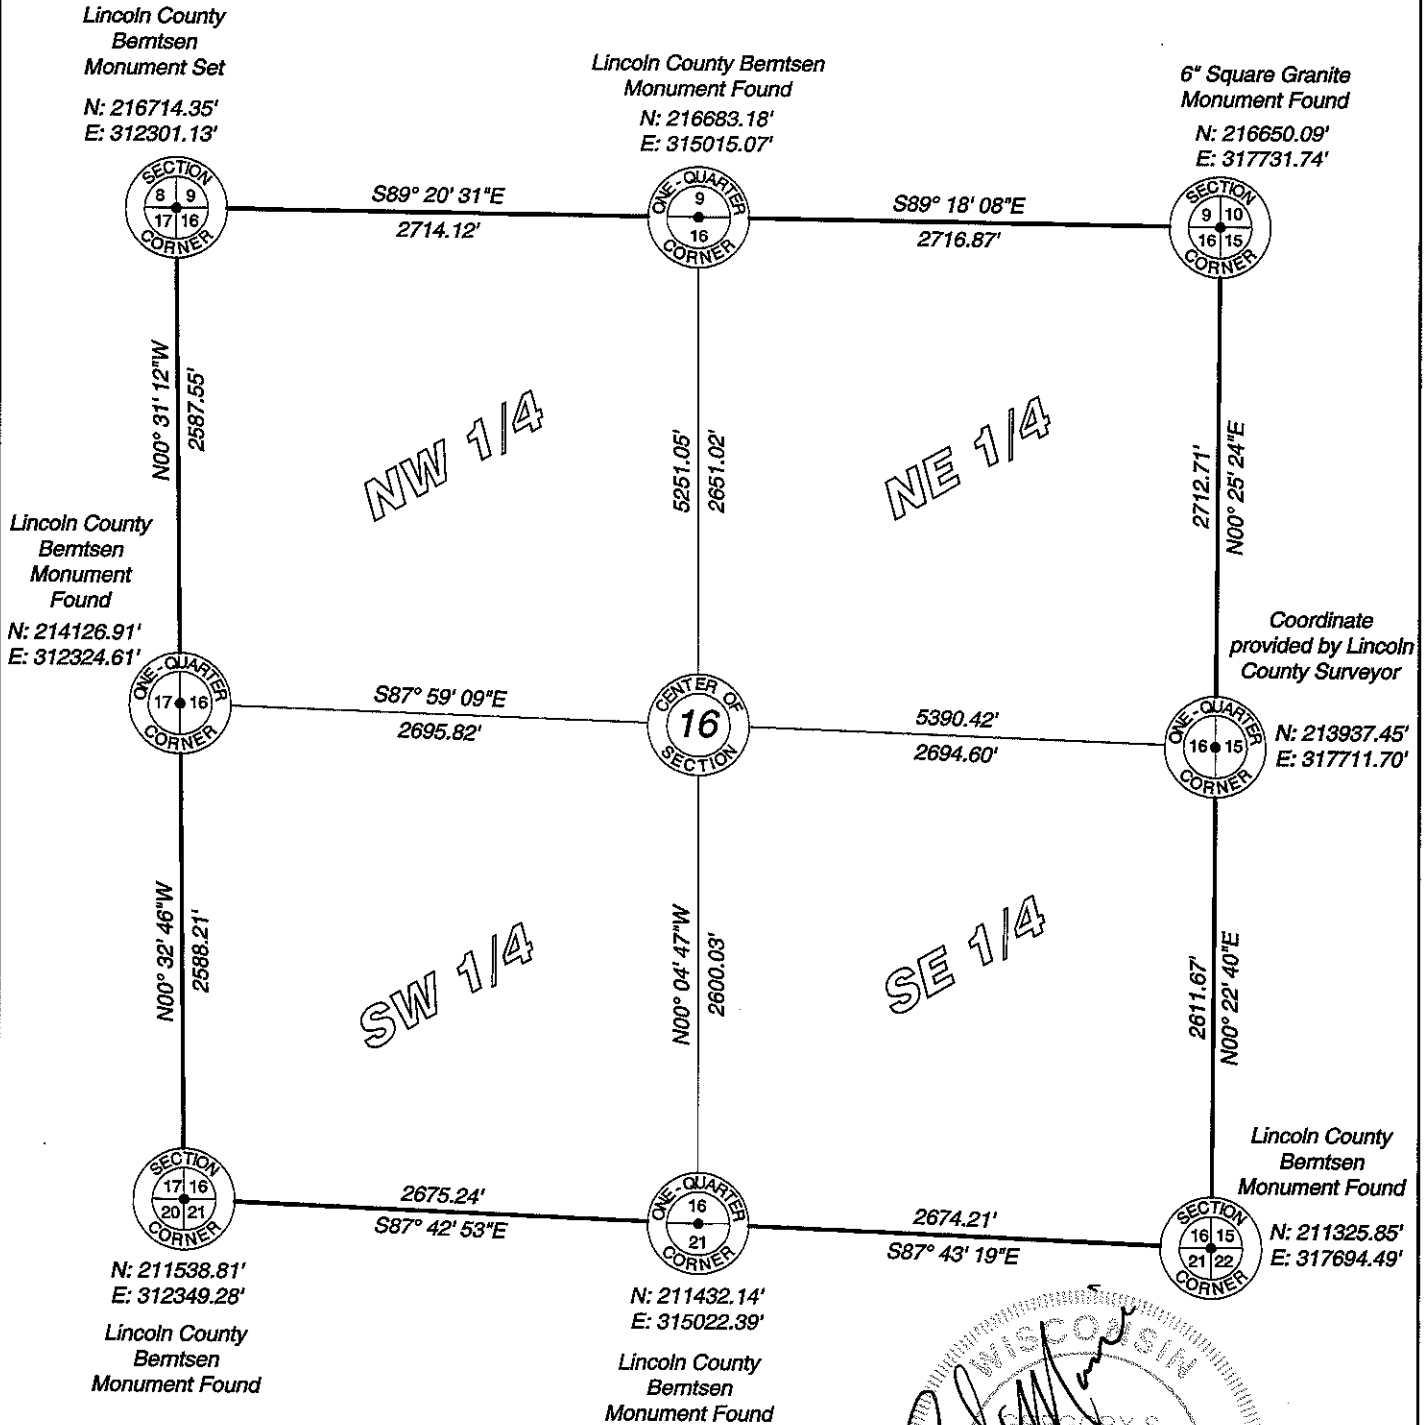

Lincoln County
Berntsen
Monument Set
N: 216714.35'
E: 312301.13'

Lincoln County Berntsen
Monument Found
N: 216683.18'
E: 315015.07'

6" Square Granite
Monument Found
N: 216650.09'
E: 317731.74'

Lincoln County
Berntsen
Monument
Found
N: 214126.91'
E: 312324.61'

Coordinate
provided by Lincoln
County Surveyor



N: 213937.45'
E: 317711.70'

N: 211538.81'
E: 312349.28'
Lincoln County
Berntsen
Monument Found

N: 211432.14'
E: 315022.39'
Lincoln County
Berntsen
Monument Found

Lincoln County
Berntsen
Monument Found
N: 211325.85'
E: 317694.49'

RECEIVED BY LINCOLN COUNTY
SURVEYOR THIS 21ST DAY
OF December 20 12
Tom Walker
COUNTY SURVEYOR

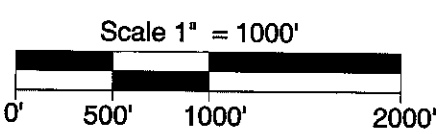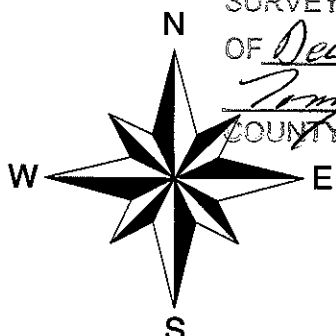

I hereby certify that the information shown hereon is true and correct to the best of my knowledge and belief.

5230 Highway 70 West
Eagle River, WI 54521
Phone 715.479.2570
Fax 715.479.7274
mainesandassociates.com

See 16