

# Lincoln County Section Summary

## Section 17, T 34 N, R 4 E

### Tomahawk Township

### Lincoln County, Wisconsin

Coordinate provided by  
Lincoln County Surveyor


N: 217249.69'  
E: 306937.07'

Lincoln County Berntsen  
Monument Found


N: 216982.53'  
E: 309616.83'

Lincoln County  
Berntsen  
Monument Set


N: 216714.35'  
E: 312301.13'

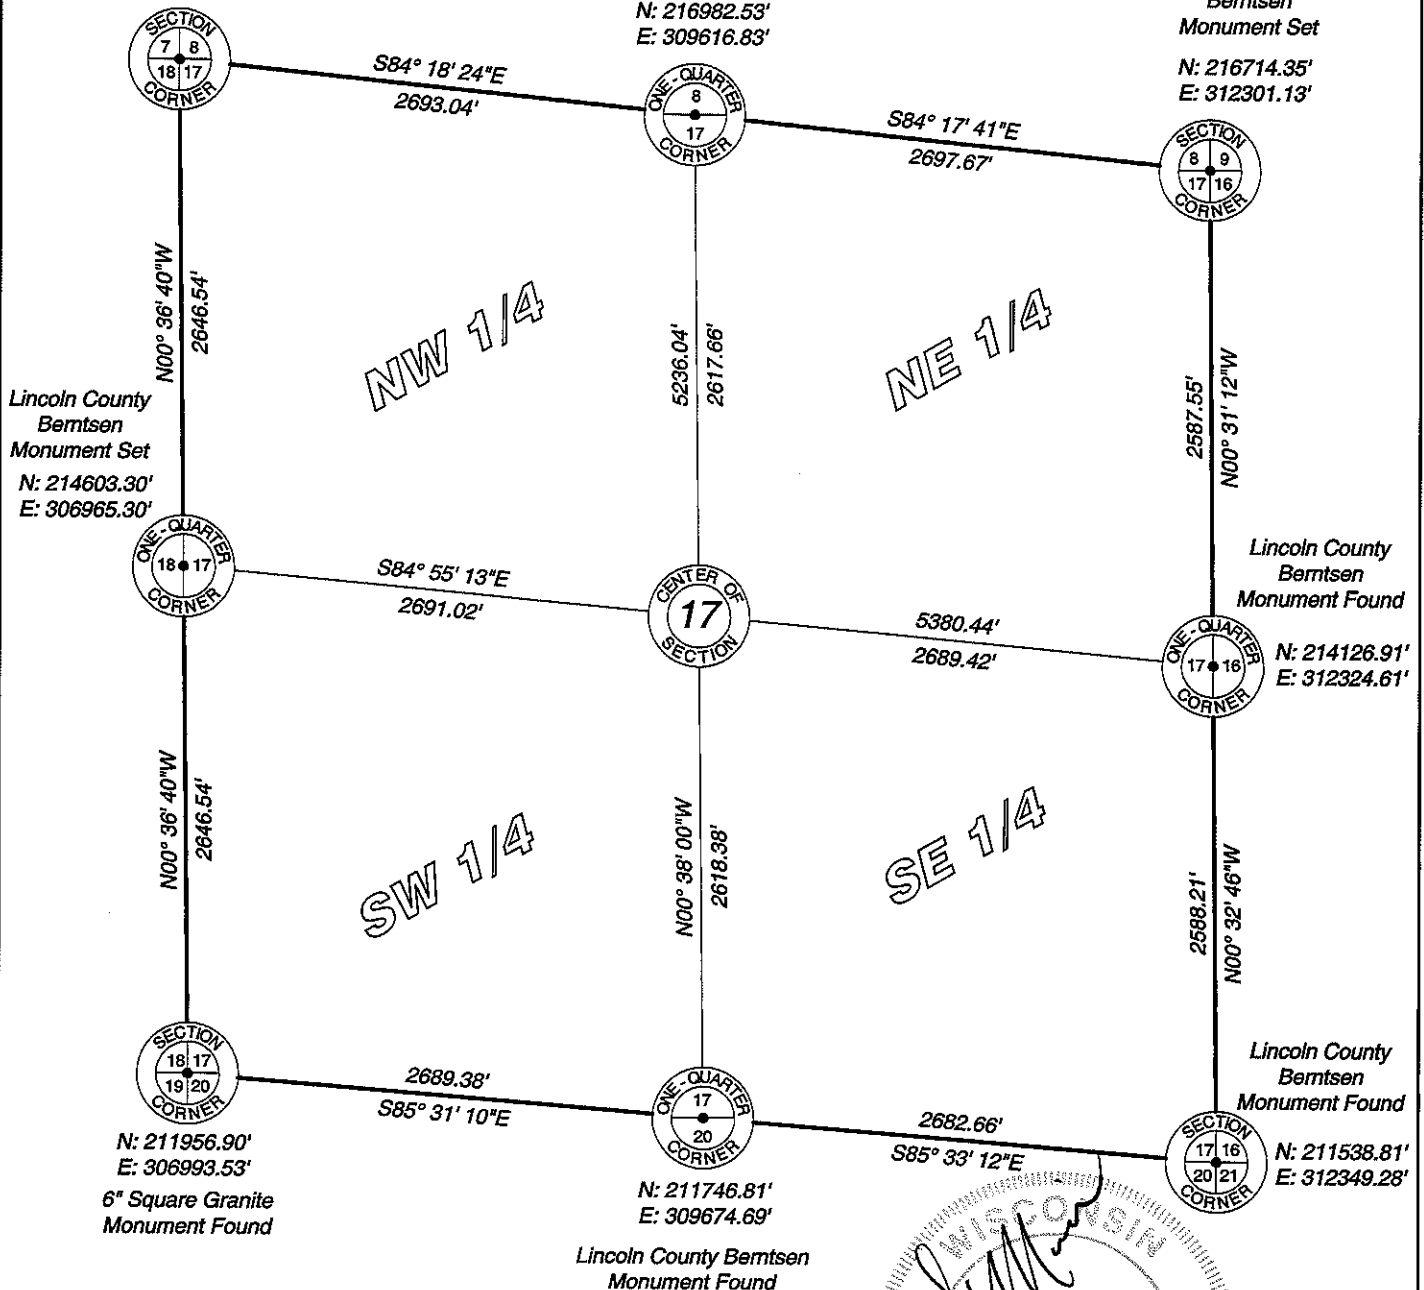


RECEIVED BY LINCOLN COUNTY  
SURVEYOR THIS 21<sup>st</sup> DAY  
OF December 20 12  
*Tom Wall*  
COUNTY SURVEYOR

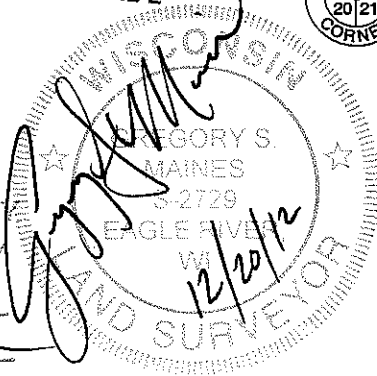

I hereby certify that the information shown hereon is true  
and correct to the best of my knowledge and belief.

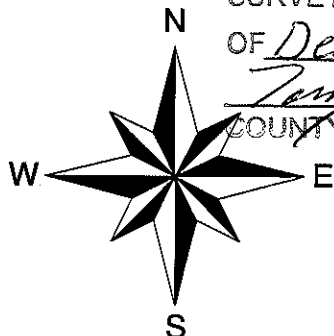

Scale 1" = 1000'

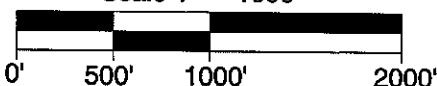

5230 Highway 70 West  
Eagle River, WI 54521

Phone 715.479.2570  
Fax 715.479.7274

mainesandassociates.com

Sec 17