


# Lincoln County Section Summary

## Section 19, T 34 N, R 4 E



### Tomahawk Township

### Lincoln County, Wisconsin

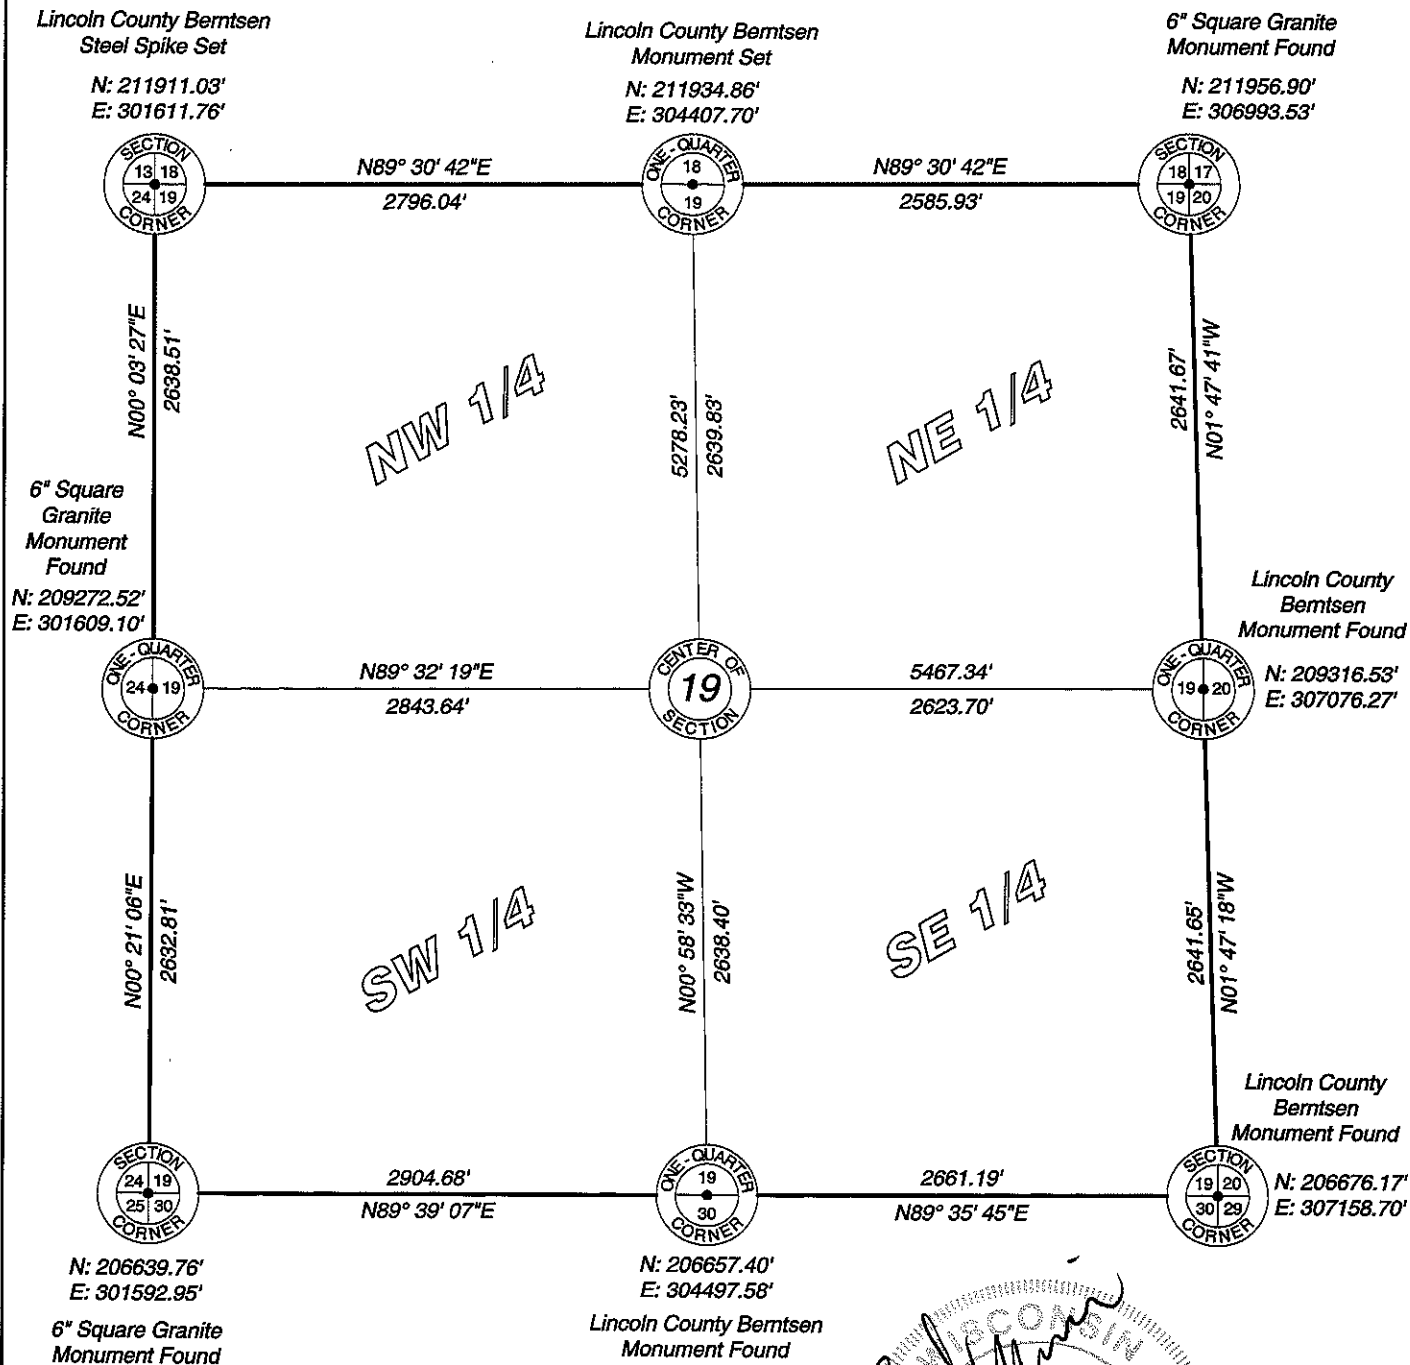

RECEIVED BY LINCOLN COUNTY SURVEYOR THIS 21<sup>ST</sup> DAY OF December 2012

*Tom Walker*  
COUNTY SURVEYOR

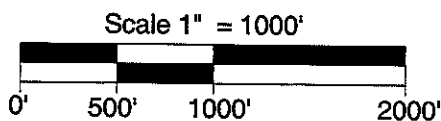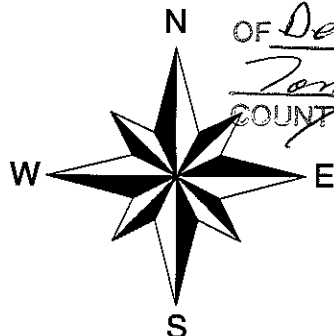

I hereby certify that the information shown hereon is true and correct to the best of my knowledge and belief.



5230 Highway 70 West  
Eagle River, WI 54521

Phone 715.479.2570  
Fax 715.479.7274

mainesandassociates.com

Sec 19