


# Lincoln County Section Summary

## Section 21, T 34 N, R 4 E



### Tomahawk Township

### Lincoln County, Wisconsin

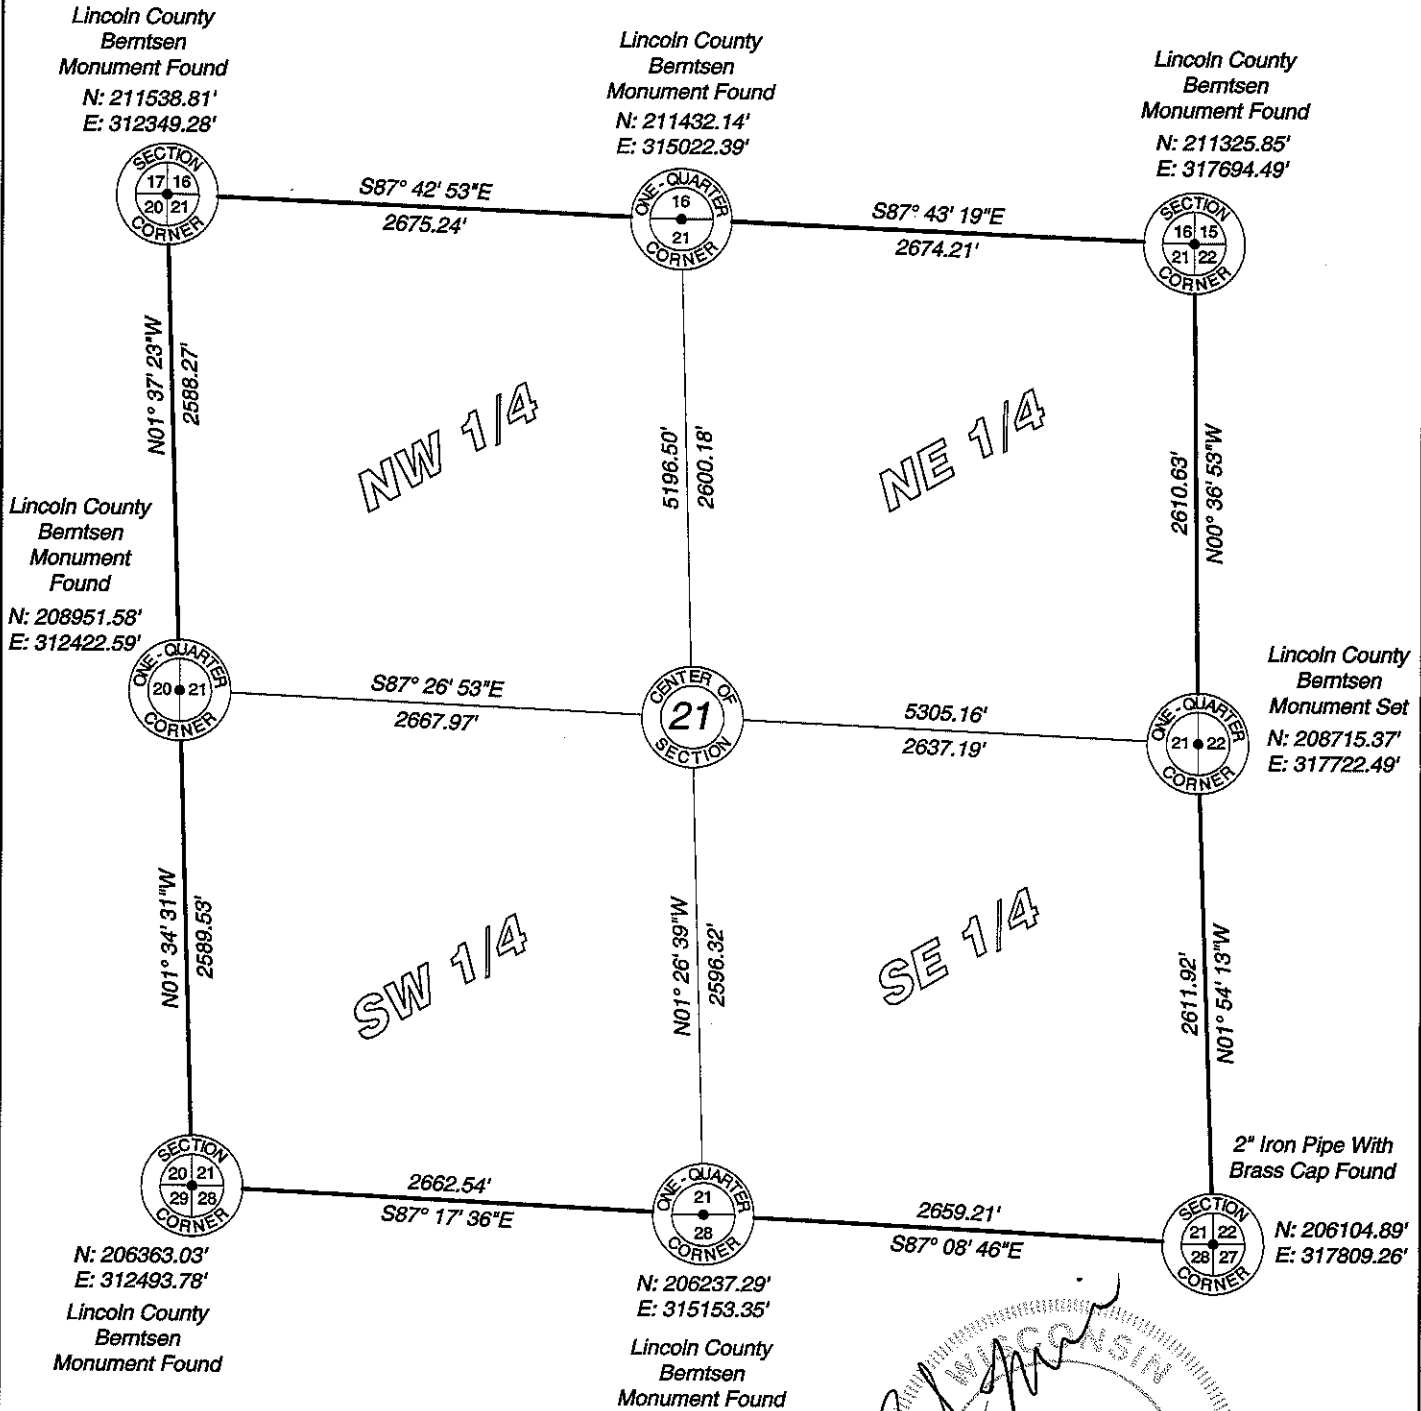

RECEIVED BY LINCOLN COUNTY  
 Lincoln County Grid  
 SURVEYOR THIS 21<sup>ST</sup> DAY  
 OF December 20, 2012  
*Tom Walter*  
 COUNTY SURVEYOR

GREGORY S. MAINES  
 S-2729  
 EAGLE RIVER, WI  
 12/20/12  
 LAND SURVEYOR

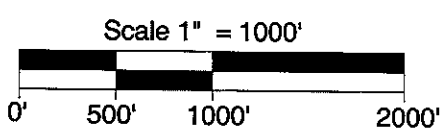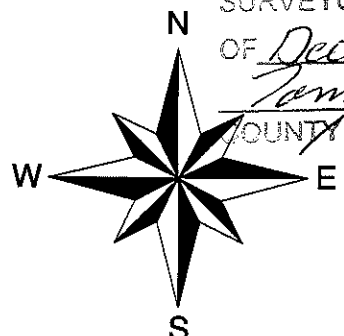

I hereby certify that the information shown hereon is true and correct to the best of my knowledge and belief.



5230 Highway 70 West  
 Eagle River, WI 54521  
 Phone 715.479.2570  
 Fax 715.479.7274  
 mainesandassociates.com

See 2/