

Lincoln County Section Summary

Section 23, T 34 N, R 4 E


Tomahawk Township

Lincoln County, Wisconsin

Coordinate provided by Lincoln County Surveyor
 N: 211578.26'
 E: 322987.27'

1" Iron Pipe Set
 N: 211717.62'
 E: 325593.43'



Coordinate provided by Lincoln County Surveyor
 N: 211856.98'
 E: 328199.59'

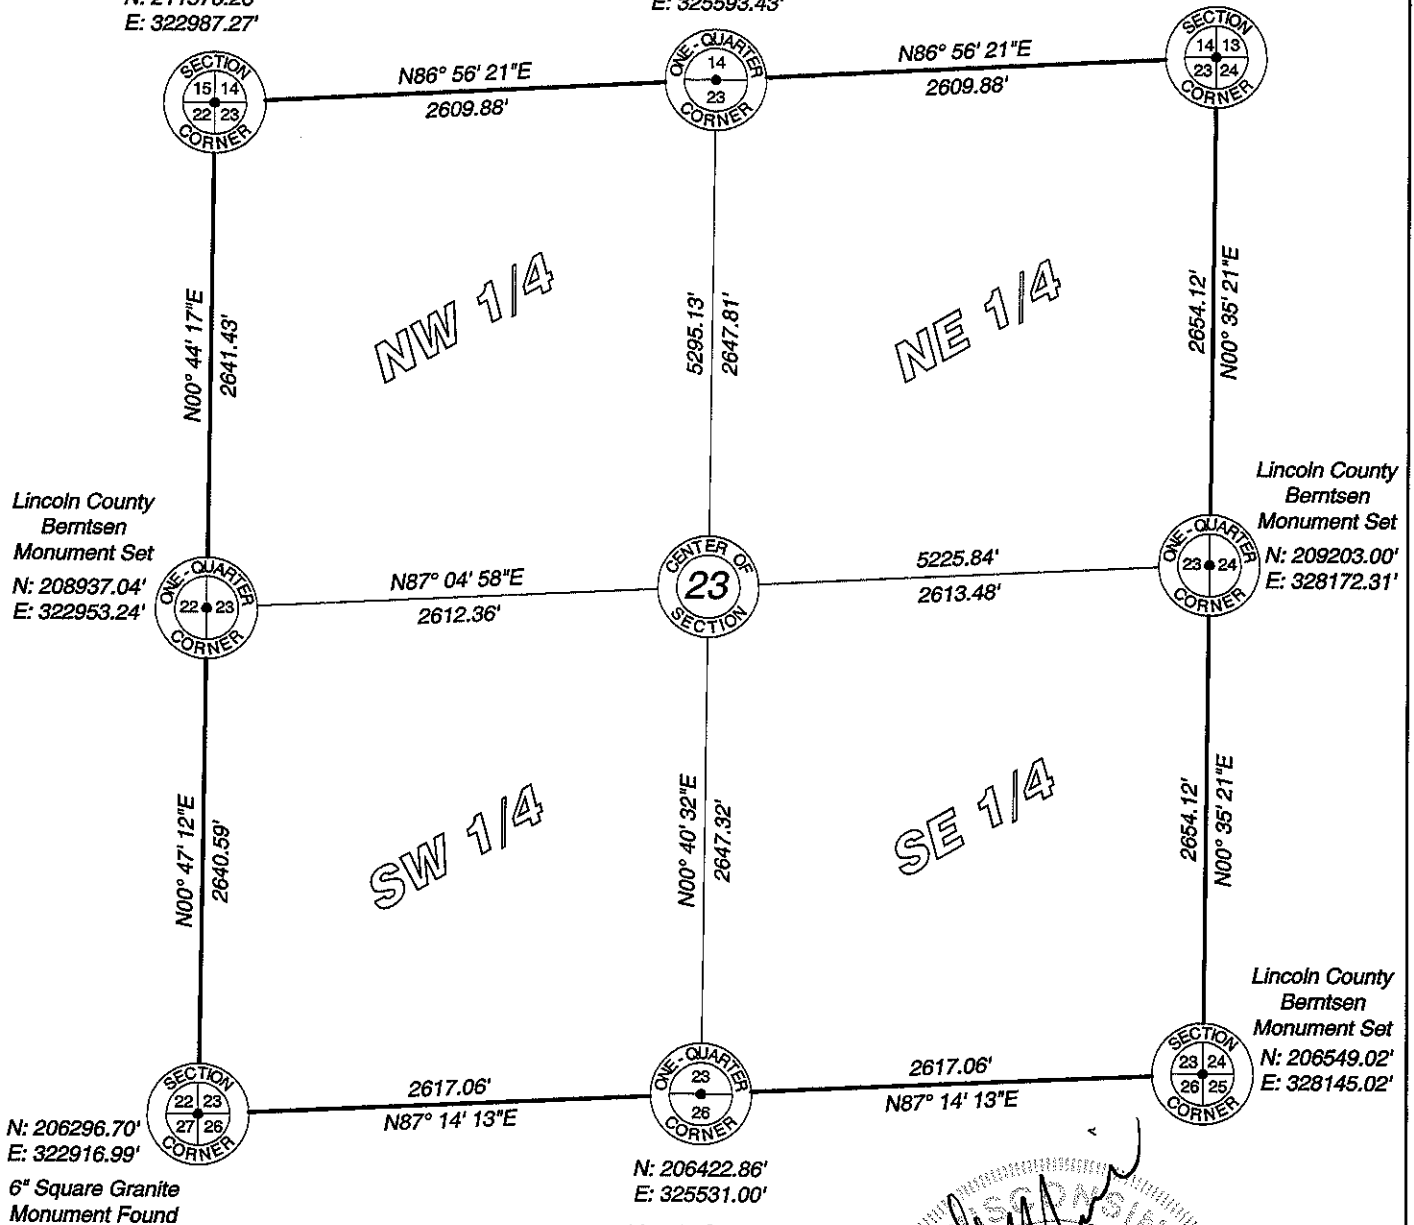

RECEIVED BY LINCOLN COUNTY SURVEYOR THIS 21ST DAY OF December 20 12
Tommy Dath
 COUNTY SURVEYOR



I hereby certify that the information shown hereon is true and correct to the best of my knowledge and belief.

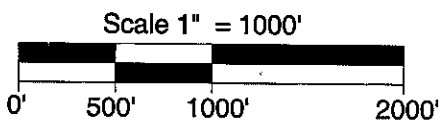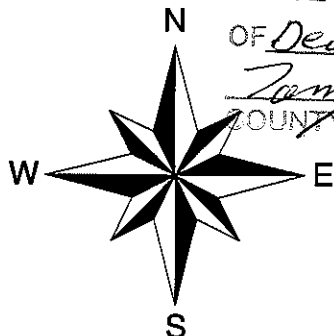

MAINES & ASSOCIATES
 Land Surveyors

5230 Highway 70 West
 Eagle River, WI 54521
 Phone 715.479.2570
 Fax 715.479.7274
mainesandassociates.com

Sec 23