

# Lincoln County Section Summary

## Section 24, T 34 N, R 4 E

### Tomahawk Township

### Lincoln County, Wisconsin

Coordinate provided by Lincoln County Surveyor


N: 211856.98'  
E: 328199.59'

Coordinate provided by Lincoln County Surveyor



N: 211832.56'  
E: 330829.96'

Coordinate provided by Lincoln County Surveyor

N: 211759.07'  
E: 333460.76'

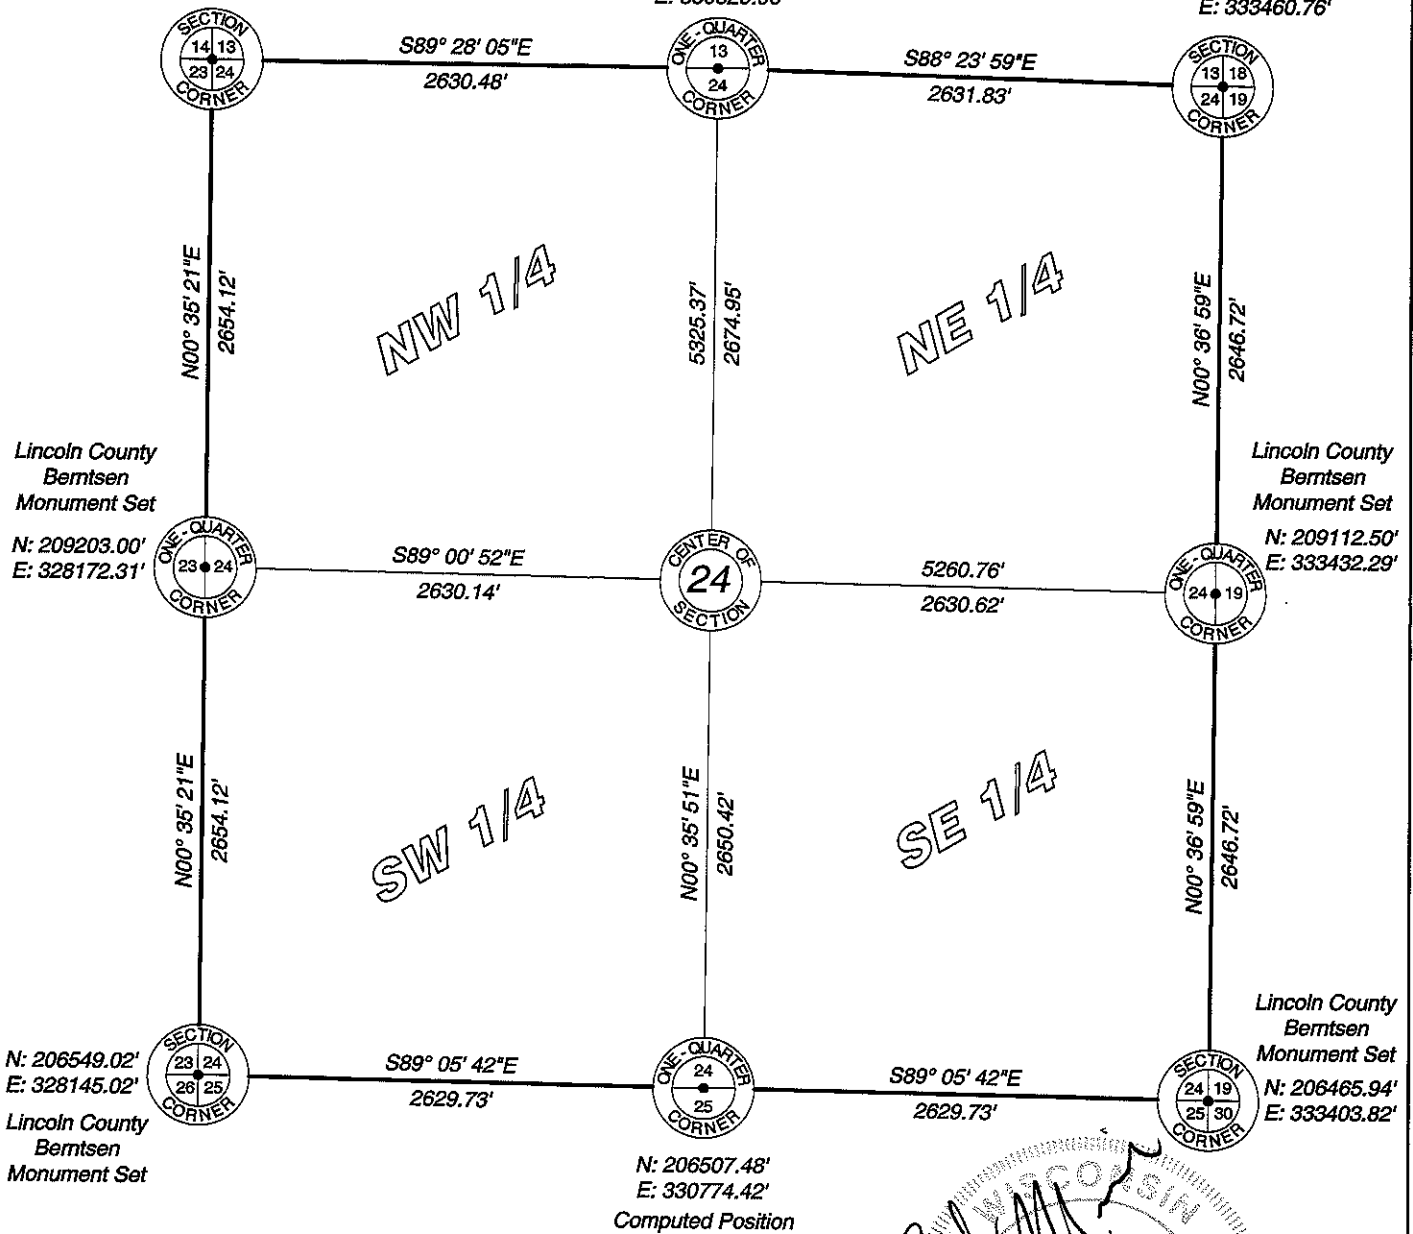

RECEIVED BY LINCOLN COUNTY SURVEYOR THIS 21<sup>ST</sup> DAY OF December 20 12  
*Tom Dally*  
 COUNTY SURVEYOR

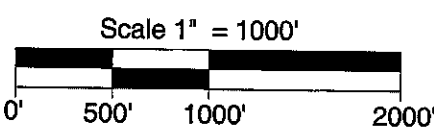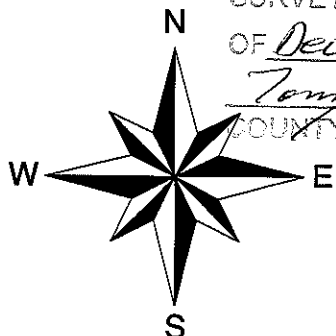

I hereby certify that the information shown hereon is true and correct to the best of my knowledge and belief.

**MAINES & ASSOCIATES**  
Land Surveyors

5230 Highway 70 West  
Eagle River, WI 54521  
Phone 715.479.2570  
Fax 715.479.7274  
mainesandassociates.com

Sec 24