




Lincoln County Section Summary

Section 33, T 34 N, R 4 E
Tomahawk Township
Lincoln County, Wisconsin

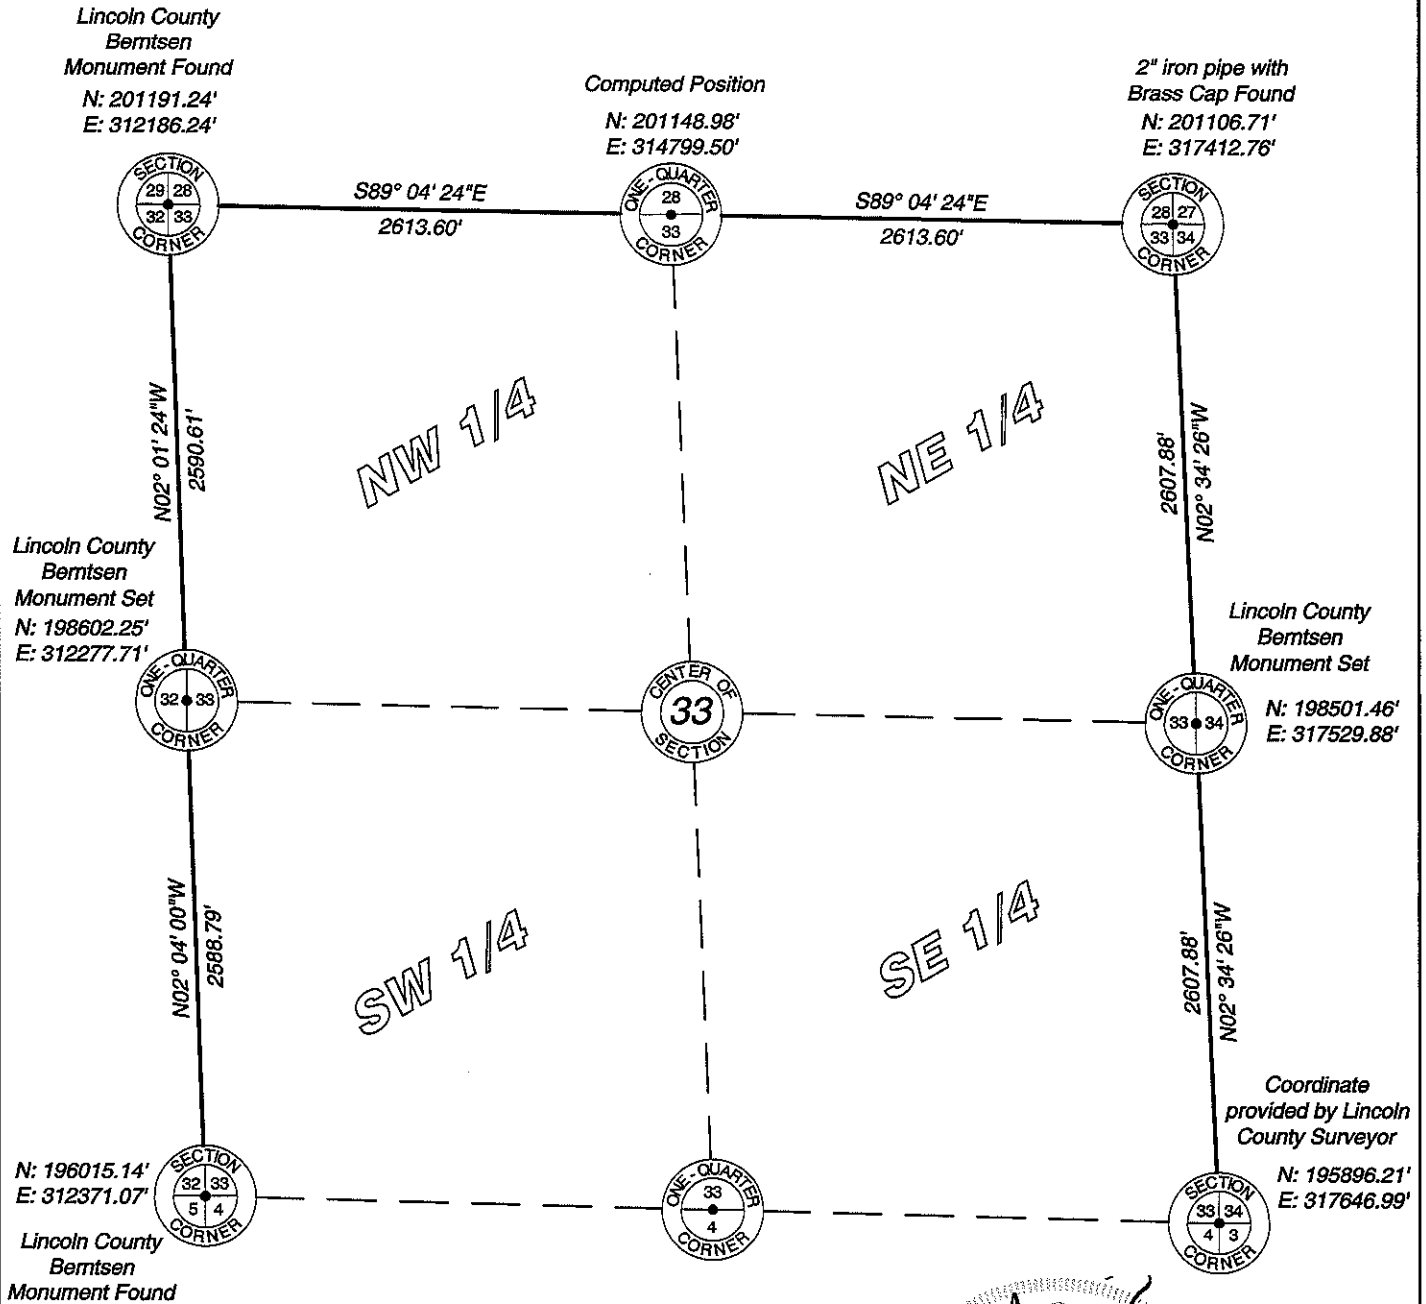

RECEIVED BY LINCOLN COUNTY SURVEYOR THIS 21st DAY OF December 20 12
Zory Dault
COUNTY SURVEYOR

GREGORY S. MAINES
S-2729
EAGLE RIVER, WI
12/20/12
LAND SURVEYOR

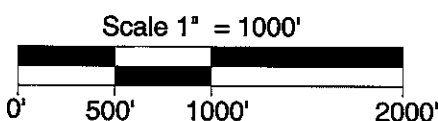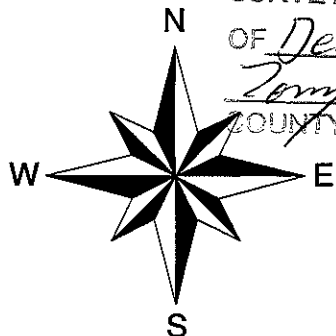

I hereby certify that the information shown hereon is true and correct to the best of my knowledge and belief.



5230 Highway 70 West
Eagle River, WI 54521
Phone 715.479.2570
Fax 715.479.7274

mainesandassociates.com

See 33