
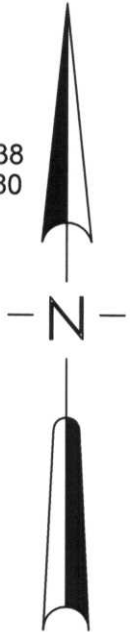


Lincoln County

SECTION SUMMARY

3	34	5
Section	Township	Range
TOMAHAWK		
Town		

RECEIVED BY LINCOLN COUNTY
 SURVEYOR THIS 13TH DAY
 OF June 20 06
Tom Walker
 COUNTY SURVEYOR

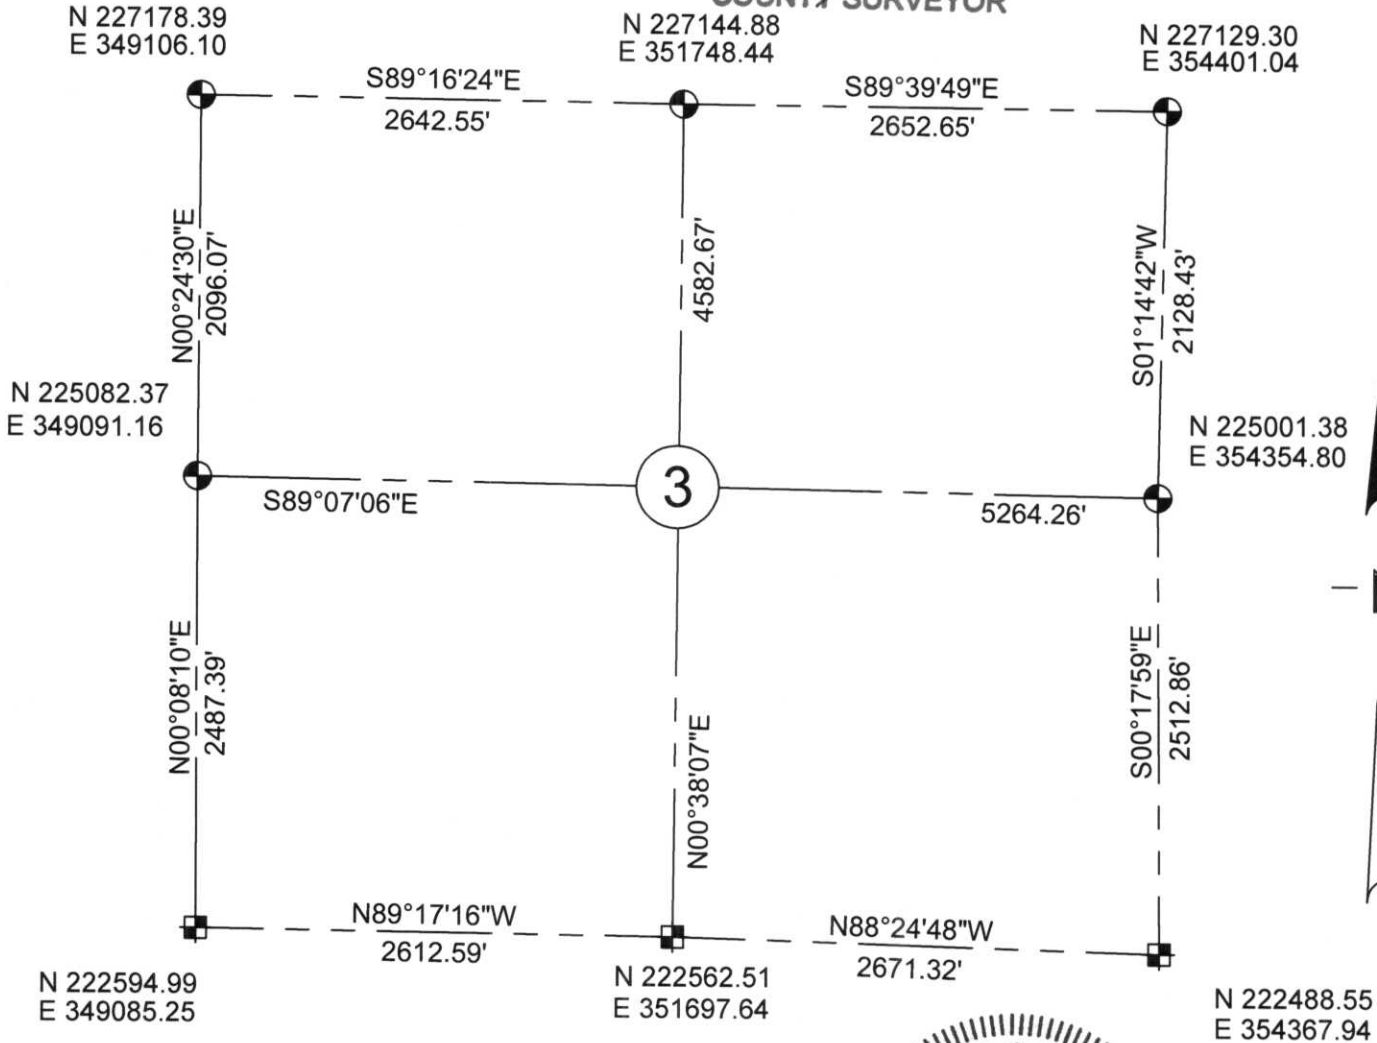

NOTE:
 BEARINGS AND COORDINATES ARE BASED ON THE
 LINCOLN COUNTY COORDINATE SYSTEM AND
 REFERENCED TO THE PINE RIVER AND PINE DELLS
 GPS STATIONS.

SEAL



LEGEND

- - BERNSTEN MONUMENT
- - FOUND MAG NAIL
- - PER TIES NO MONUMENT SET
- - SURVEY MARKING PIN

CERTIFIED CORRECT:

Keith J. Walkowski
 KEITH J. WALKOWSKI
 Registered Land Surveyor

DATE: 6-13-06