


Lincoln County Surveyor

SECTION SUMMARY 13 34 5
 Section Township Range
 TOMAHAWK
 Town

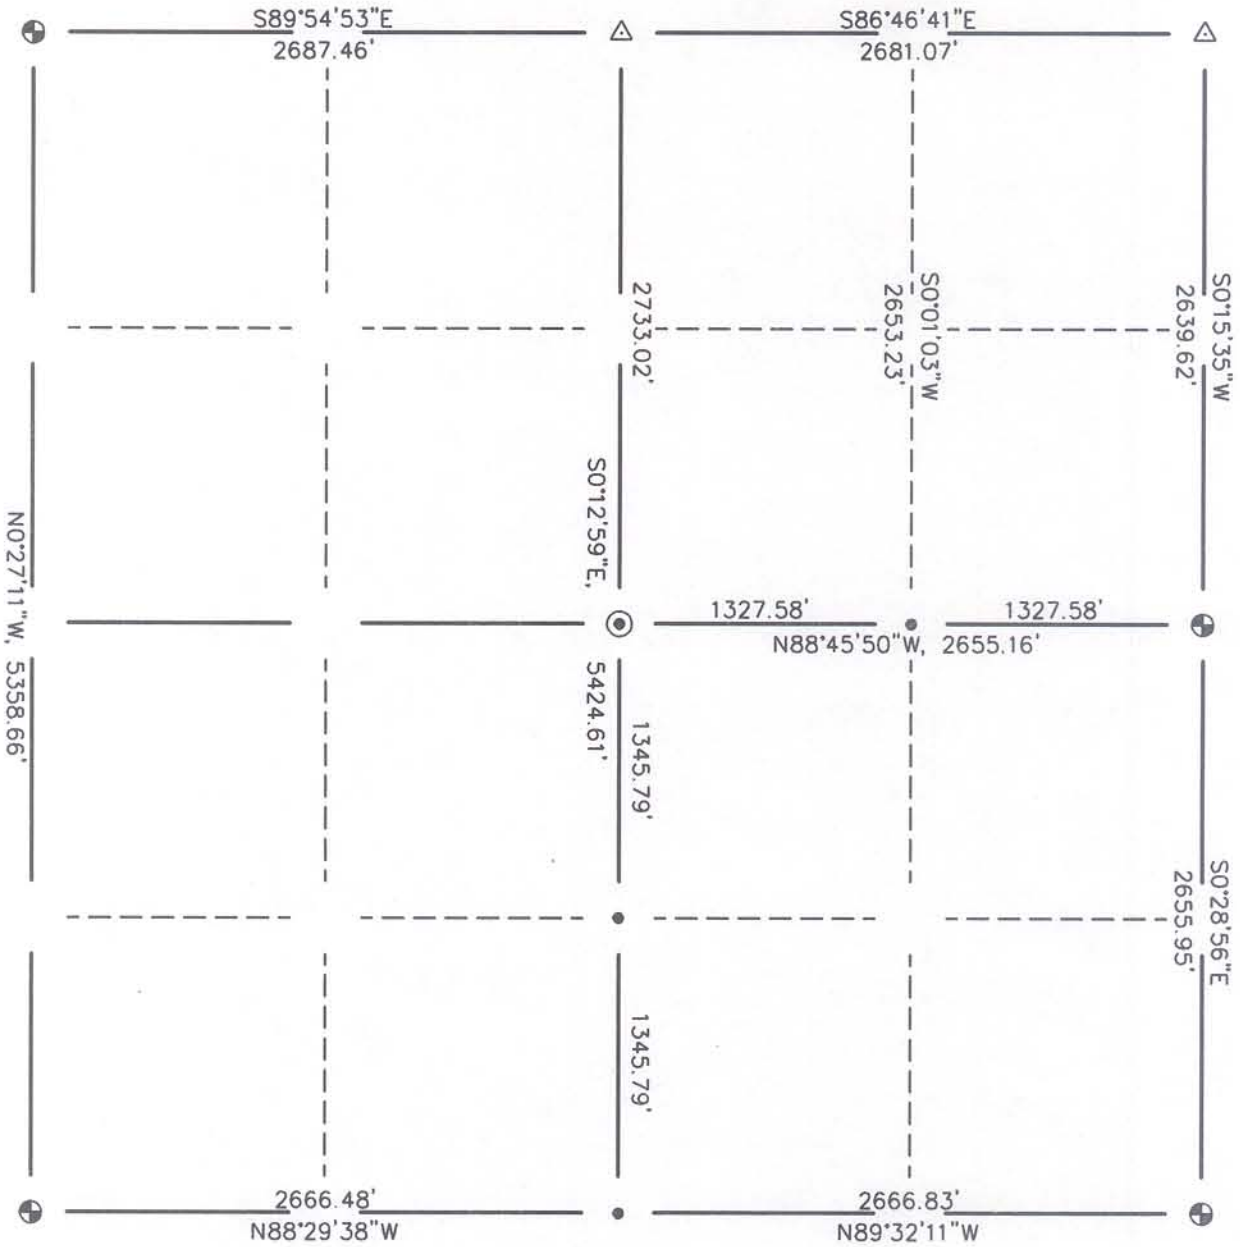

LEGEND

- ⊕ - Berntsen Monument
- ⊙ - 2-1/2" (od) Iron Pipe
- - 1-1/4" (od) Iron Pipe
- △ - PK Nail



CERTIFIED CORRECT:
 William W. Nutter, RLS

William W. Nutter
 Registered Land Surveyor
 DATE: 4-7-2004