

Lincoln County Section Summary

Section 17, T 34 N, R 5 E


Tomahawk Township

Lincoln County, Wisconsin

Coordinate
provided by Lincoln
County Surveyor
N: 217178.15'
E: 338471.31'

Coordinate
provided by Lincoln
County Surveyor
N: 217150.94'
E: 341067.49'

Coordinate
provided by Lincoln
County Surveyor
N: 217191.87'
E: 343698.47'

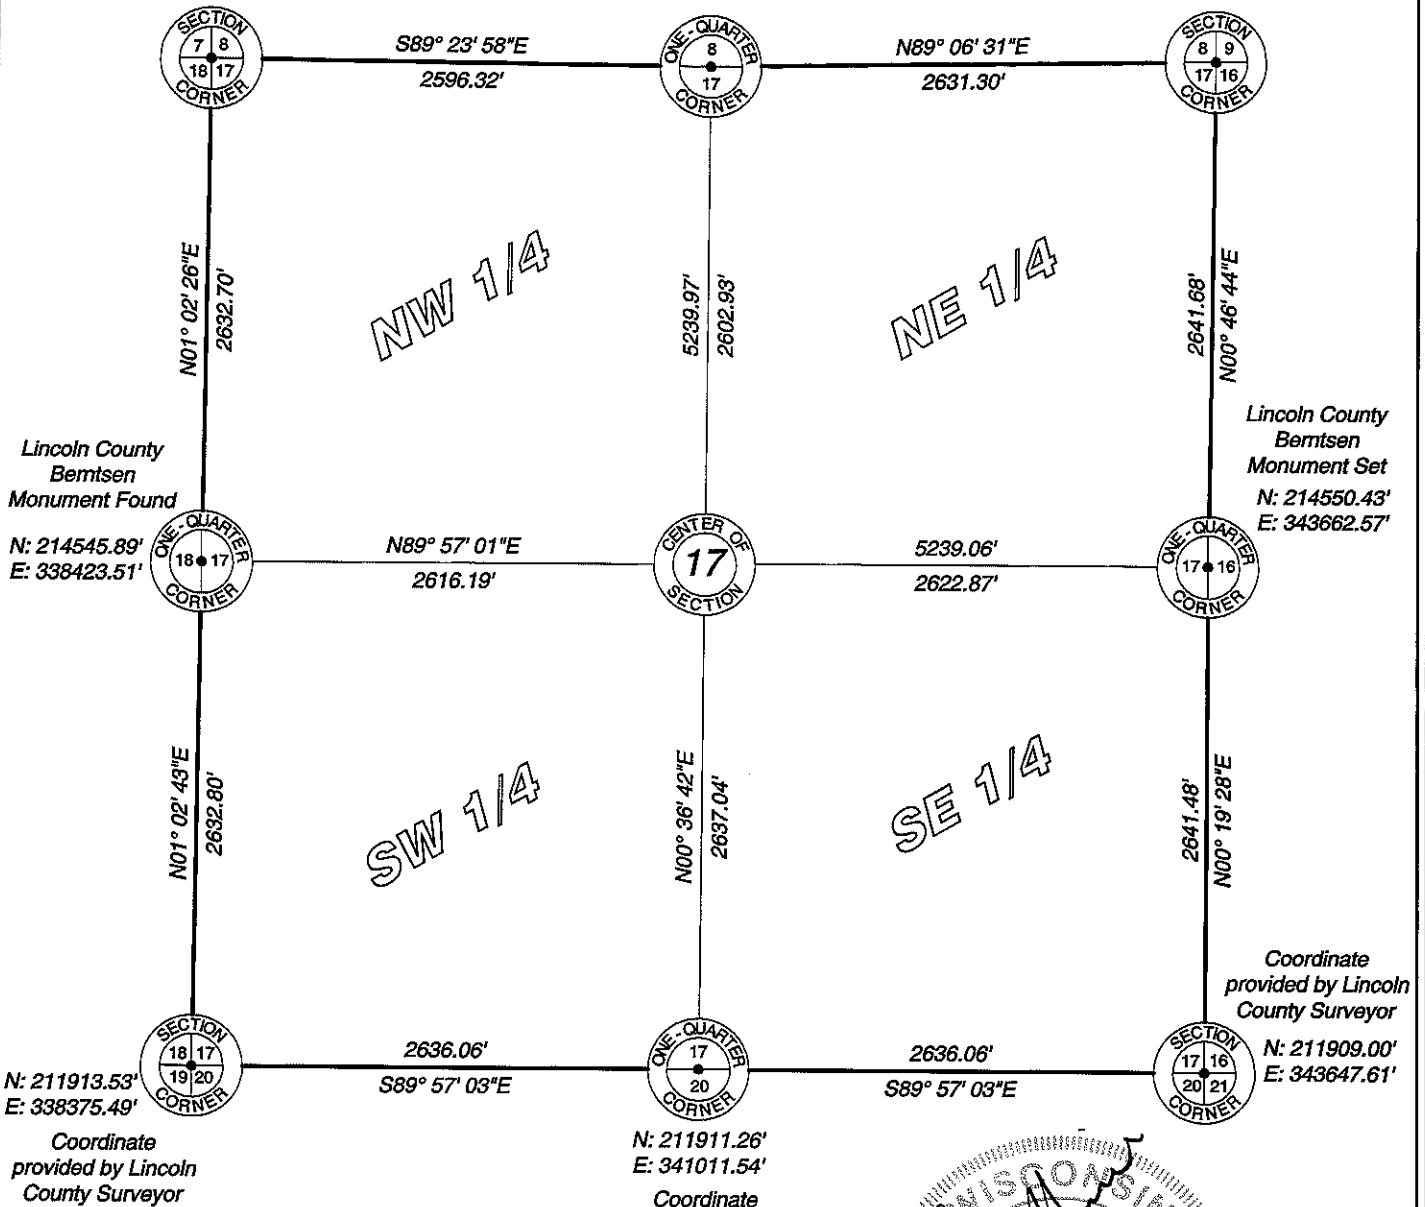

Lincoln County
Bemtsen
Monument Found
N: 214545.89'
E: 338423.51'




Lincoln County
Bemtsen
Monument Set
N: 214550.43'
E: 343662.57'

Coordinate
provided by Lincoln
County Surveyor

Coordinate
provided by Lincoln
County Surveyor

Coordinate
provided by Lincoln
County Surveyor

RECEIVED BY LINCOLN COUNTY
SURVEYOR THIS 21ST DAY
OF December 20 12
Tom Daller
COUNTY SURVEYOR

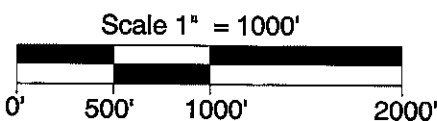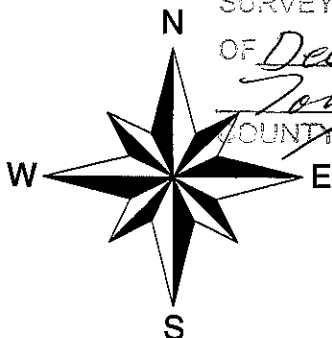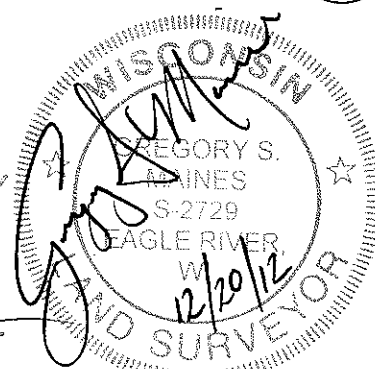

I hereby certify that the information shown hereon is true and correct to the best of my knowledge and belief.



MAINES & ASSOCIATES
Land Surveyors mainesandassociates.com

5230 Highway 70 West
Eagle River, WI 54521
Phone 715.479.2570
Fax 715.479.7274

Sec 17