

Lincoln County Section Summary

Section 21, T 34 N, R 5 E


Tomahawk Township

Lincoln County, Wisconsin


Coordinate
provided by Lincoln
County Surveyor
N: 211909.00'
E: 343647.61'

Coordinate
provided by Lincoln
County Surveyor
N: 211903.85'
E: 346279.64'

Coordinate
provided by Lincoln
County Surveyor
N: 211898.89'
E: 348911.86'

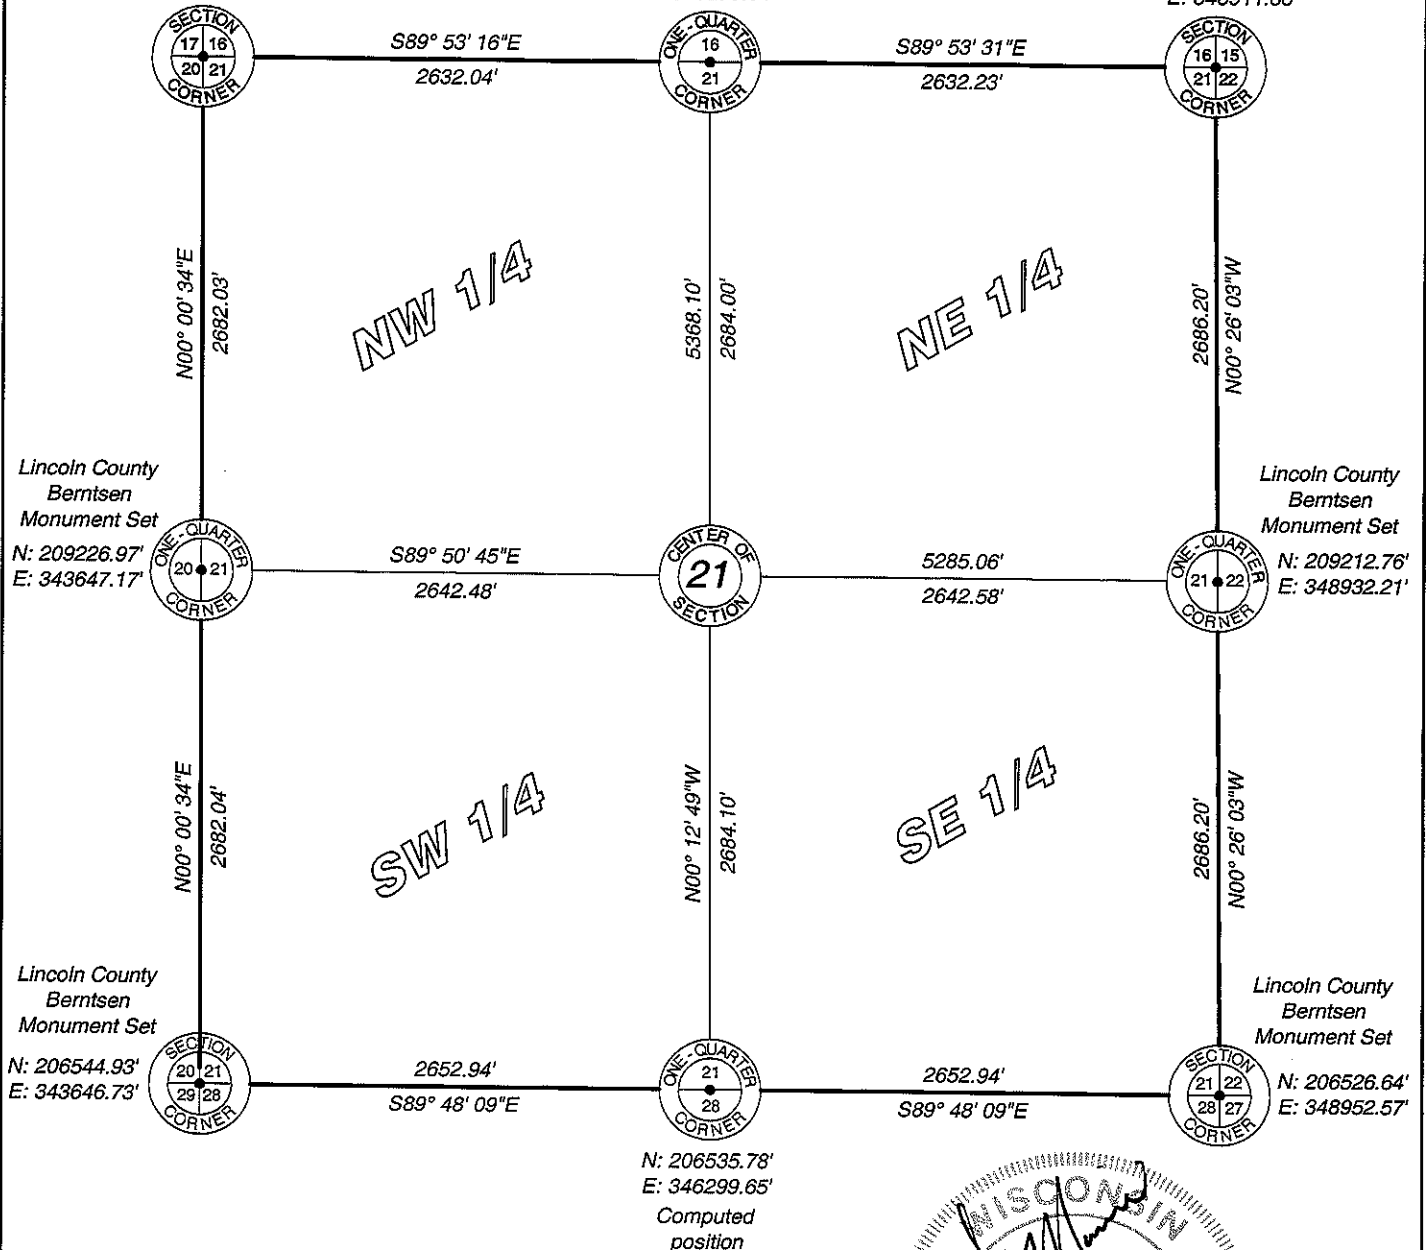


Lincoln County Grid

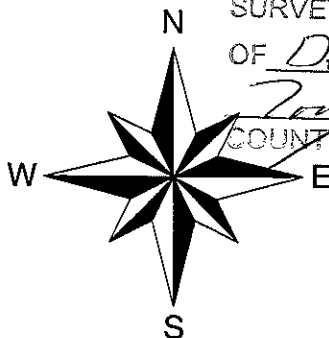

Scale 1" = 1000'



RECEIVED BY LINCOLN COUNTY
SURVEYOR THIS 21ST DAY
OF December 20 12
Tom Dallen
COUNTY SURVEYOR

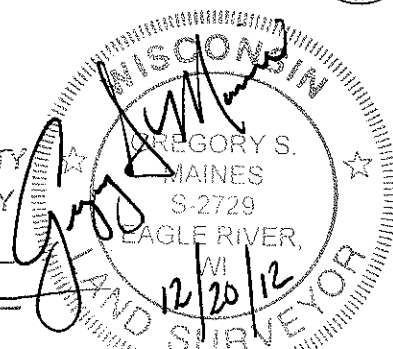

I hereby certify that the information shown hereon is true and correct to the best of my knowledge and belief.



MAINES & ASSOCIATES
Land Surveyors

5230 Highway 70 West
Eagle River, WI 54521
Phone 715.479.2570
Fax 715.479.7274

mainesandassociates.com

Sec 21