


Lincoln County Section Summary

Section 25, T 34 N, R 5 E



Tomahawk Township

Lincoln County, Wisconsin

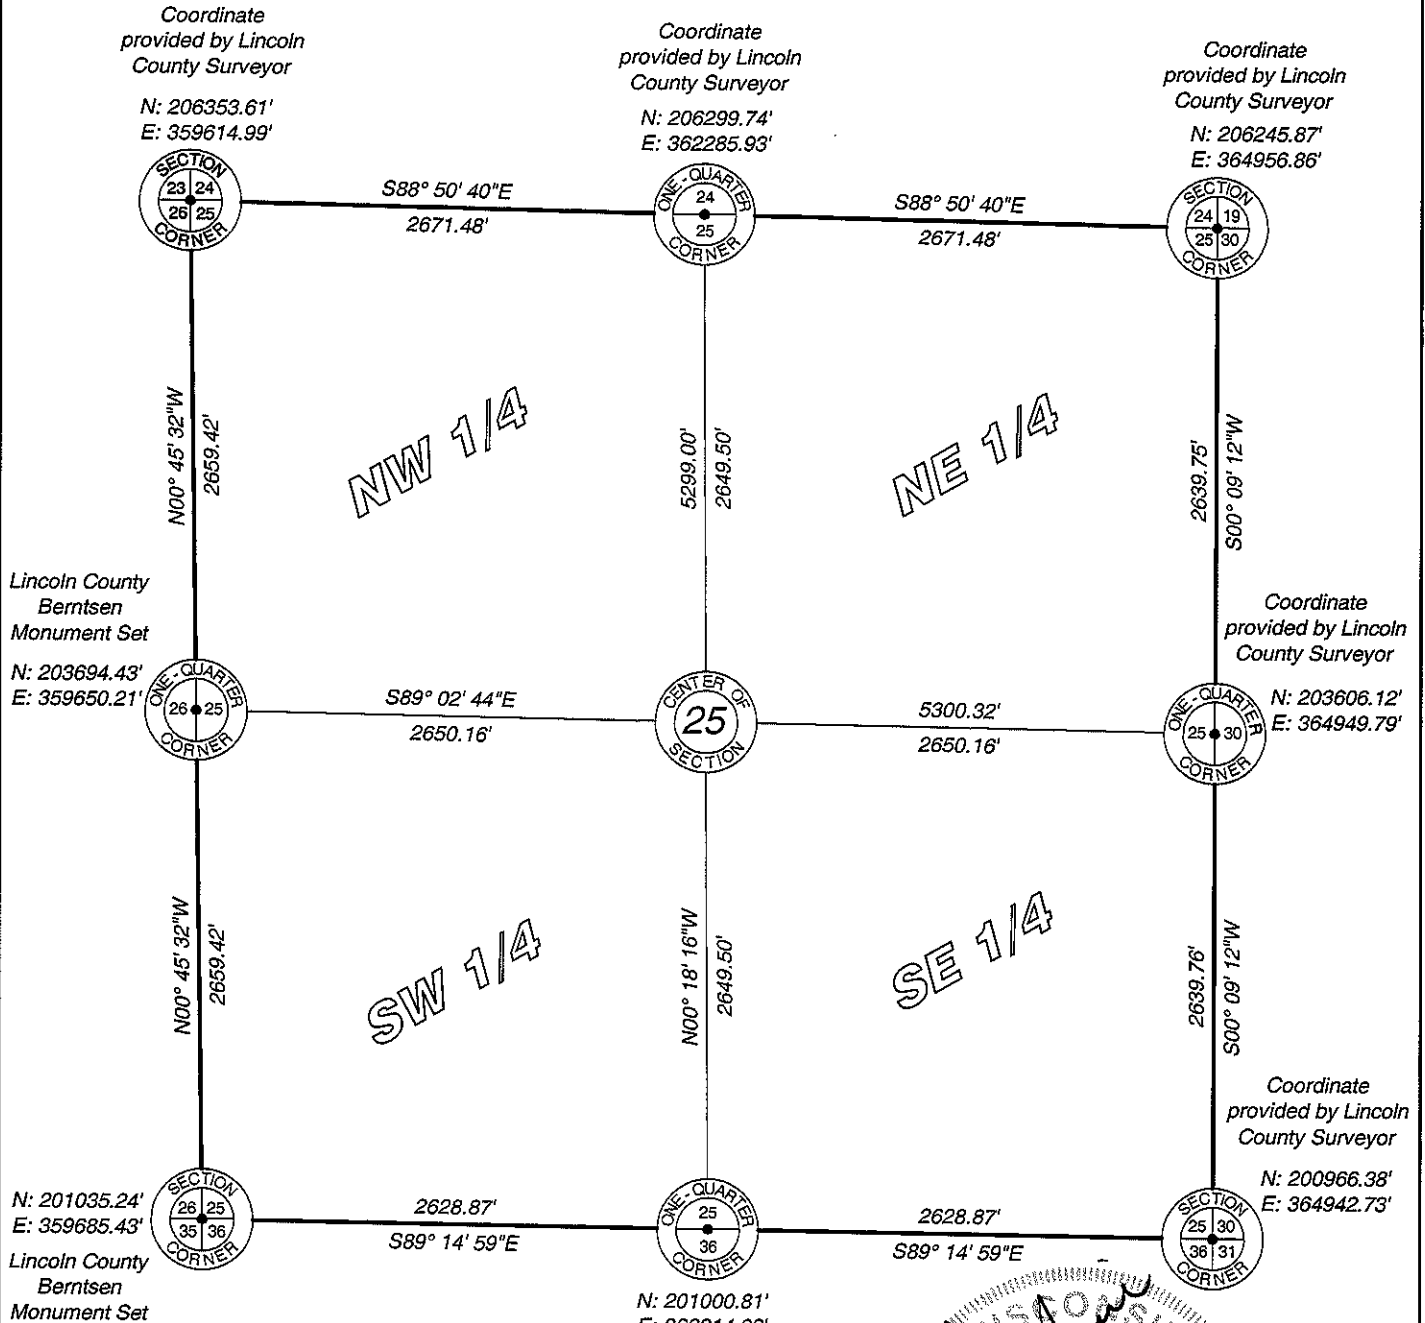

RECEIVED BY LINCOLN COUNTY SURVEYOR THIS 21ST DAY OF December 20 12
Tom Dallen
 COUNTY SURVEYOR

WISCONSIN
 GREGORY S. MAINES
 S-2729
 EAGLE RIVER, WI
 12/20/12
 LAND SURVEYOR

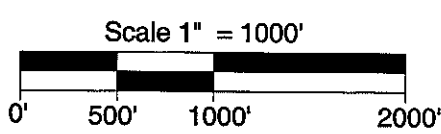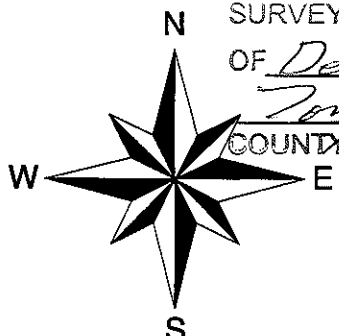

I hereby certify that the information shown hereon is true and correct to the best of my knowledge and belief.

5230 Highway 70 West
 Eagle River, WI 54521
 Phone 715.479.2570
 Fax 715.479.7274
 mainesandassociates.com

Sec 25