

Lincoln County Section Summary

Section 36, T 34 N, R 5 E


Tomahawk Township

Lincoln County, Wisconsin

Lincoln County
Berntsen
Monument Set
N: 201035.24'
E: 359685.43'



Lincoln County
Berntsen
Monument Set
N: 201000.81'
E: 362314.08'

Coordinate
provided by Lincoln
County Surveyor
N: 200966.38'
E: 364942.73'

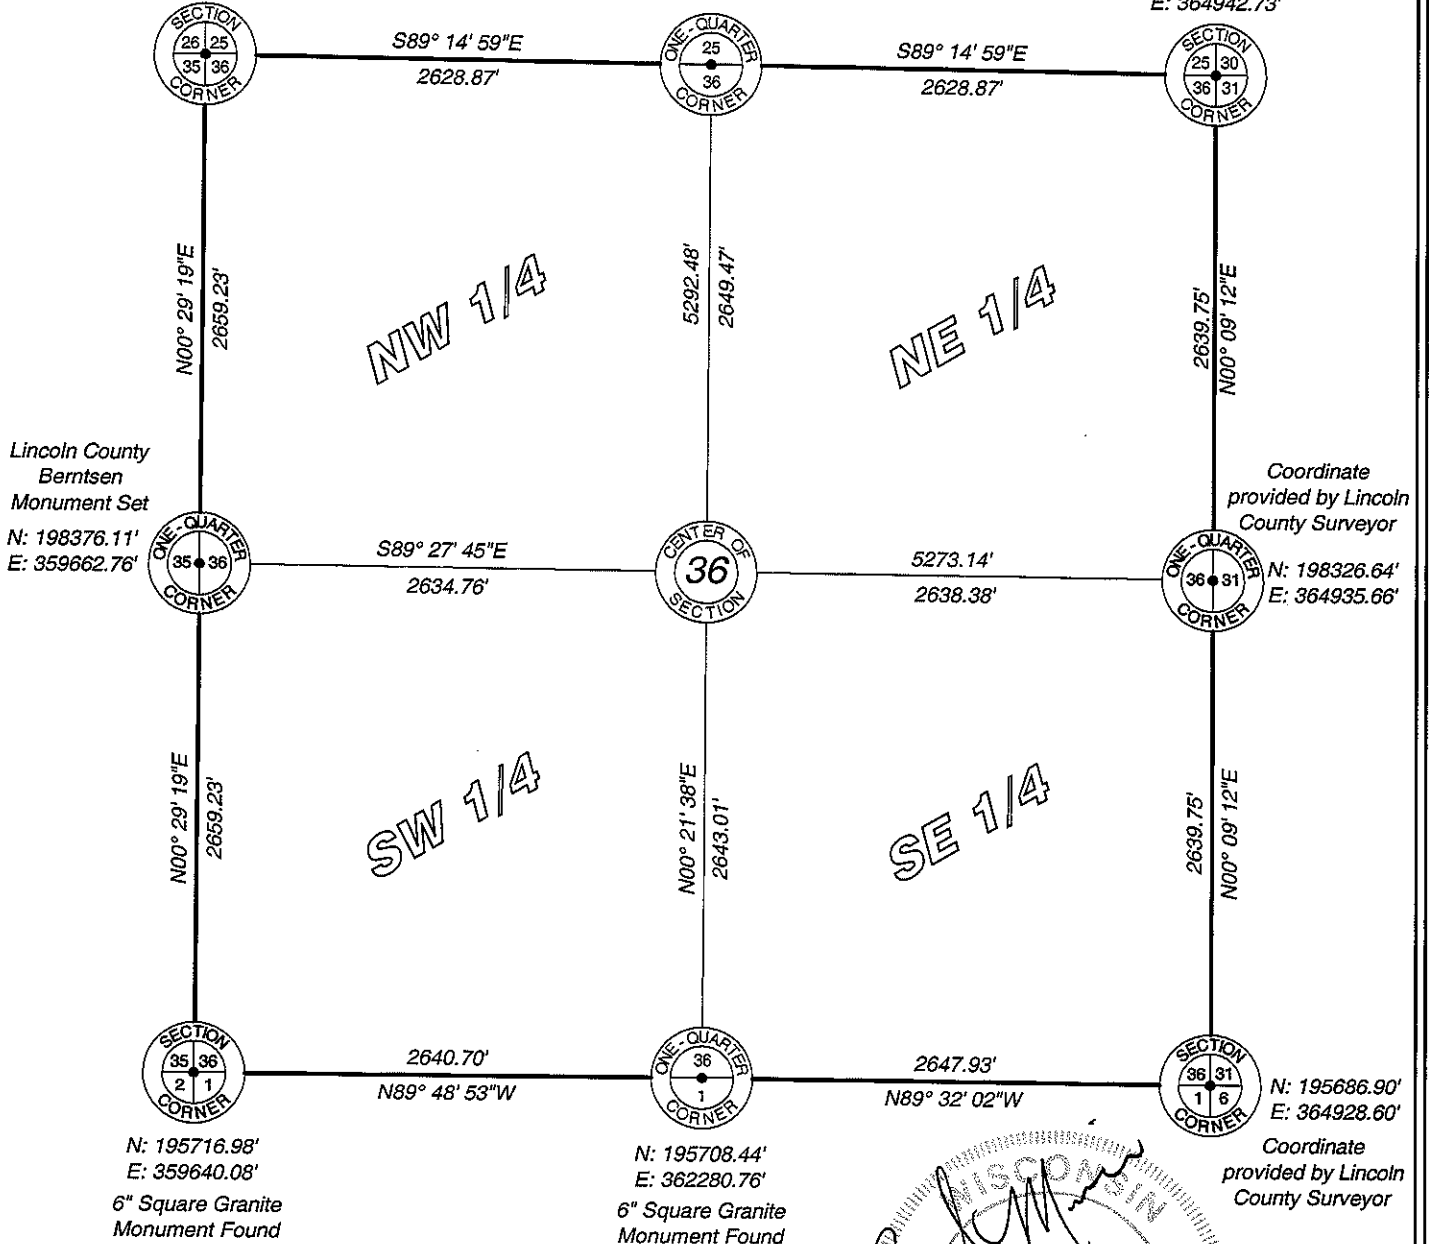


Lincoln County Grid

RECEIVED BY LINCOLN COUNTY
SURVEYOR THIS 21ST DAY
OF December 20, 12
Tom Diller
COUNTY SURVEYOR

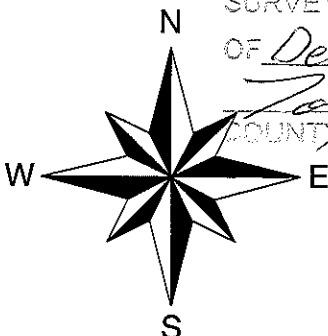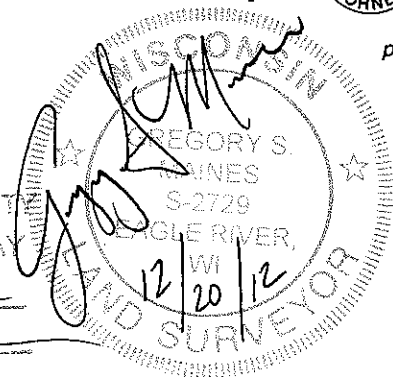

Scale 1" = 1000'

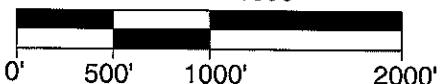

I hereby certify that the information shown hereon is true and correct to the best of my knowledge and belief.



MAINES & ASSOCIATES
Land Surveyors

5230 Highway 70 West
Eagle River, WI 54521
Phone 715.479.2570
Fax 715.479.7274

mainesandassociates.com

Sec 36