




SECTION SUMMARY
 4 - 34N - 6E
 Section Township Range
BRADLEY
 Town

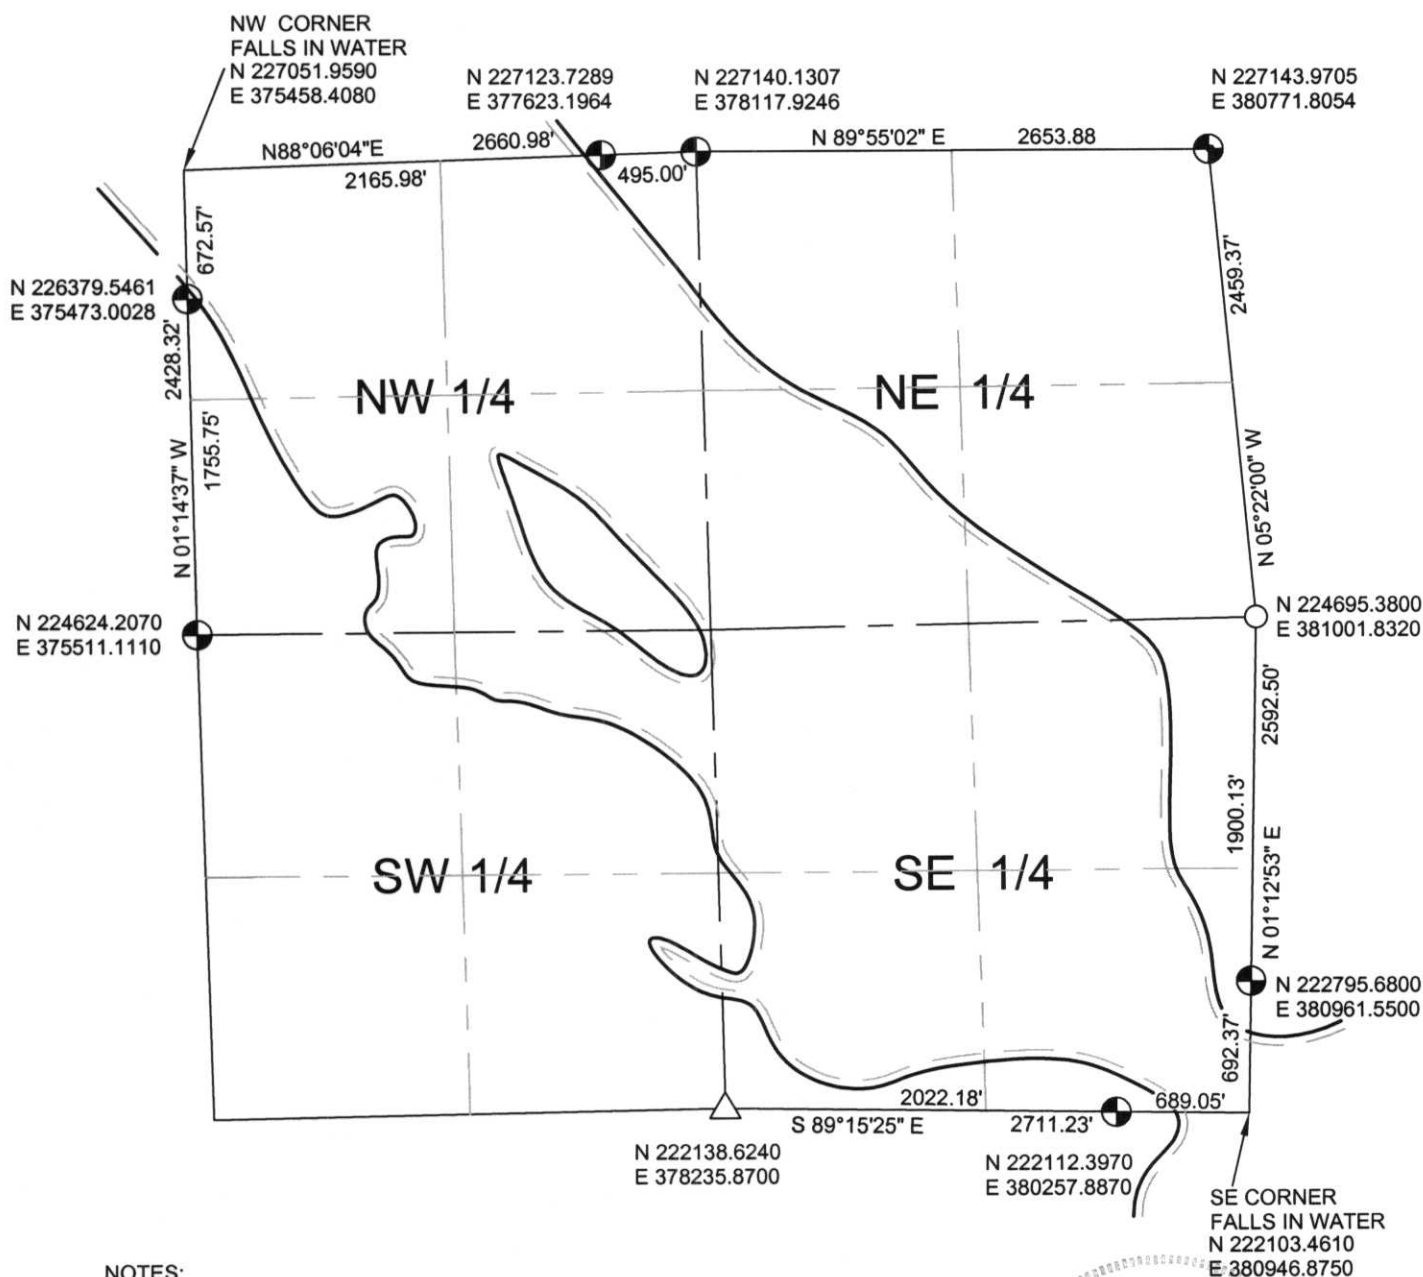

NOTES:
 COORDINATES AND BEARINGS ARE REFERENCED TO THE LINCOLN COUNTY COORDINATE SYSTEM AS DEVELOPED BY THE WISCONSIN DEPARTMENT OF TRANSPORTATION AND WERE DETERMINED BY GPS OBSERVATIONS ON CONTROL POINTS AS SUPPLIED BY THE DOT.

LEGEND

- ⊕ - Lincoln County Monument
- - Stone Monument
- - PK Nail
- - Iron Bar
- △ - Spike

RECEIVED AT LINCOLN COUNTY
 COURTHOUSE THIS 6TH DAY
 OF February 2002
Tommy Deth
 LAND INFORMATION OFFICE



CERTIFIED CORRECT:

Thomas A. Radenz
 Registered Land Surveyor

DATE: 2/5/02

AE: 9/13