


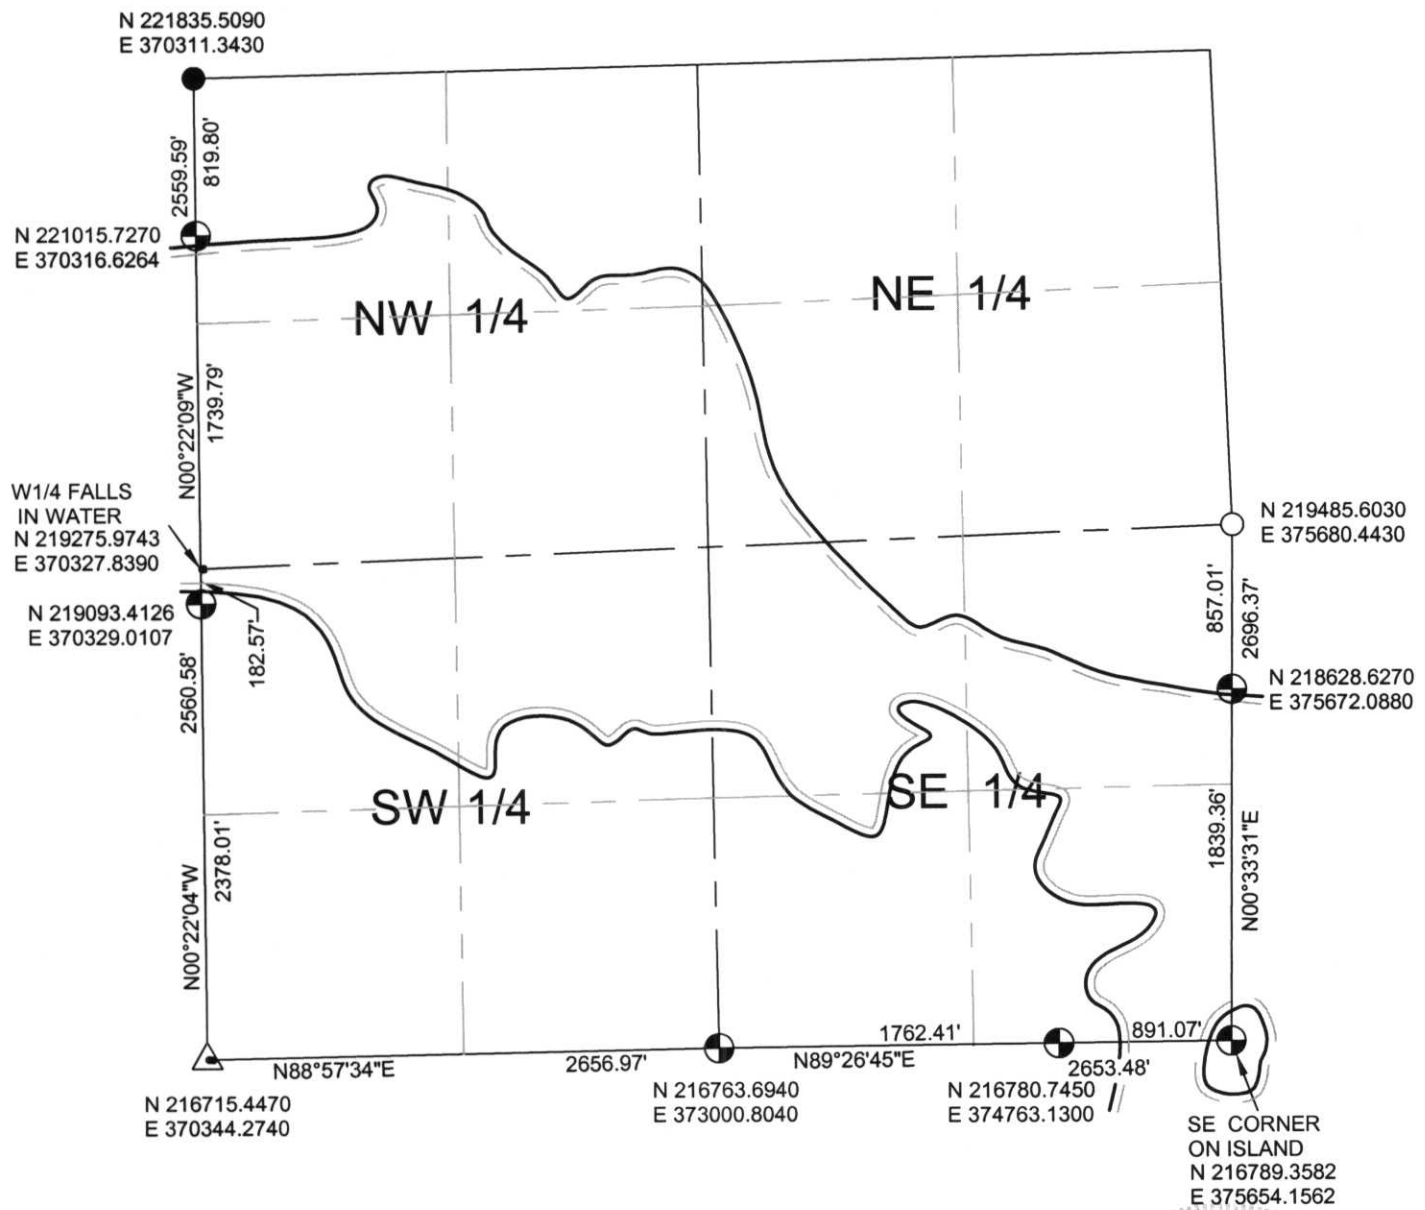

SECTION SUMMARY  
8 - 34N - 6E  
Section Township Range  
**BRADLEY**  
Town

RECEIVED AT LINCOLN COUNTY  
COURTHOUSE THIS 9<sup>th</sup> DAY  
OF January 20 02  
Tony Dallen  
LAND INFORMATION OFFICE



NOTES:  
COORDINATES AND BEARINGS ARE REFERENCED TO THE LINCOLN COUNTY COORDINATE SYSTEM AS DEVELOPED BY THE WISCONSIN DEPARTMENT OF TRANSPORTATION AND WERE DETERMINED BY GPS OBSERVATIONS ON CONTROL POINTS AS SUPPLIED BY THE DOT.

- LEGEND**
- - Lincoln County Monument
  - - Stone Monument
  - - 1-1/2" Iron Pipe
  - - RR Spike
  - △ - PK Nail



CERTIFIED CORRECT:  
Thomas A. Radenz  
Registered Land Surveyor  
DATE: 4/8/02

E.I.:59