




SECTION SUMMARY  
 12 - 34N - 6E  
 Section Township Range  
**BRADLEY**  
 Town

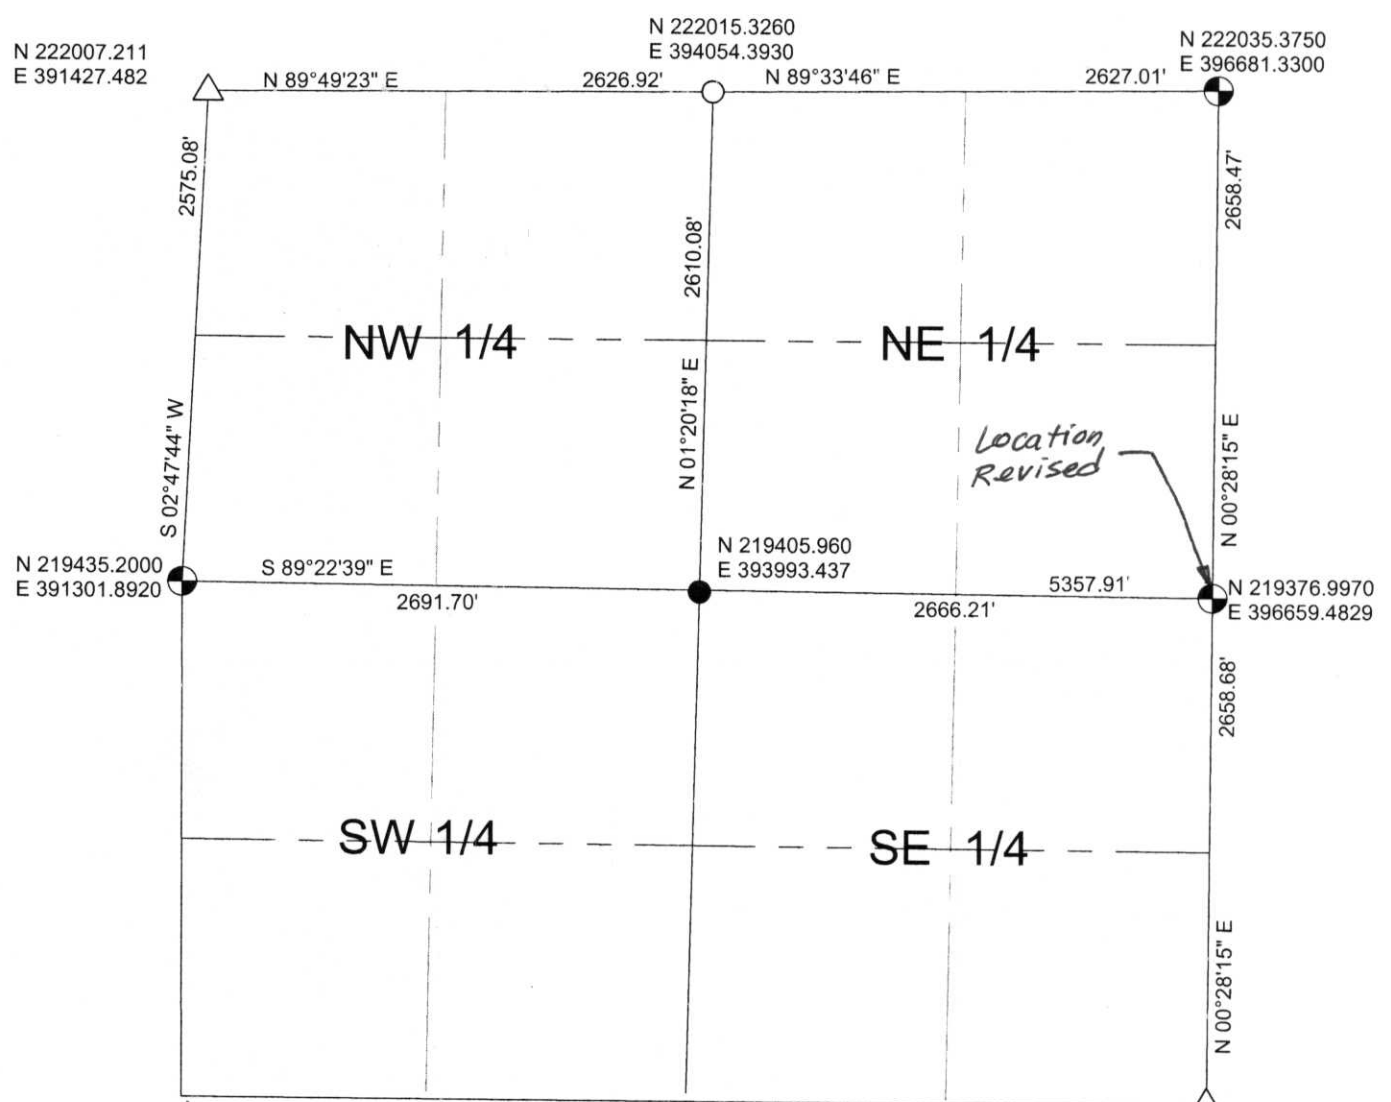

\* This map is to correct & supercede maps of Sec. 12, T34N, R6E submitted previously by REI, Thomas Rodenz, and/or David Renaud


N 216718.4110  
 E 396637.6340

DAR  
 5-6-8

NOTES:  
 COORDINATES AND BEARINGS ARE REFERENCED TO THE LINCOLN COUNTY COORDINATE SYSTEM AS DEVELOPED BY THE WISCONSIN DEPARTMENT OF TRANSPORTATION AND WERE DETERMINED BY GPS OBSERVATIONS ON CONTROL POINTS AS SUPPLIED BY THE DOT.

- LEGEND**
- - Lincoln County Monument
  - - Stone Monument
  - - PK Nail
  - - 2" Iron Pipe
  - △ - Corner to be set by County Surveyor


RECEIVED BY LINCOLN COUNTY  
 SURVEYOR THIS 7<sup>TH</sup> DAY  
 OF May 20 08  
*Tom Dahl*  
 COUNTY SURVEYOR

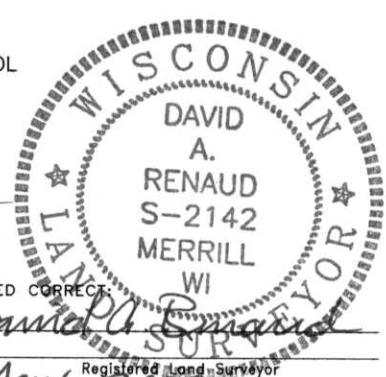

CERTIFIED CORRECT  
*David A. Renaud*  
 Registered Land Surveyor  
 DATE: May 6, 2008



SECTION SUMMARY  
 12 - 34N - 6E  
 Section Township Range  
**BRADLEY**  
 Town

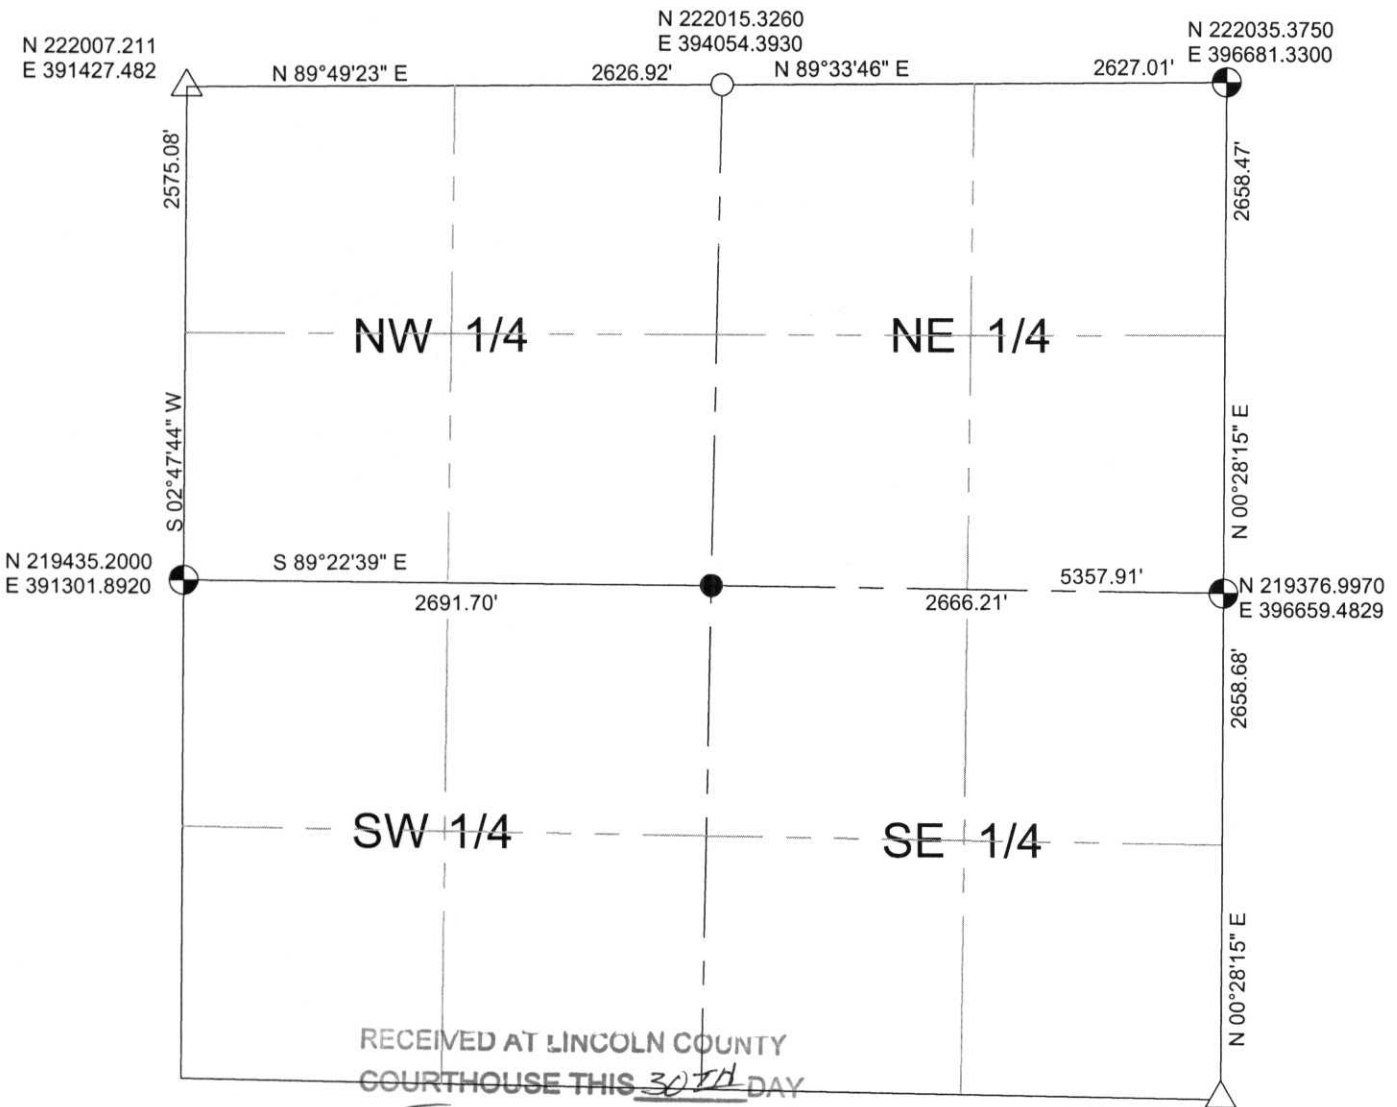

NOTES:  
 COORDINATES AND BEARINGS ARE REFERENCED TO THE LINCOLN COUNTY  
 COORDINATE SYSTEM AS DEVELOPED BY THE WISCONSIN DEPARTMENT OF  
 TRANSPORTATION AND WERE DETERMINED BY GPS OBSERVATIONS ON CONTROL  
 POINTS AS SUPPLIED BY THE DOT.

- LEGEND**
- ⊙ - Lincoln County Monument
  - - Stone Monument
  - - PK Nail
  - - 2" Iron Pipe
  - △ - Corner to be set by County Surveyor



CERTIFIED CORRECT:  
*Thomas A. Radenz*  
 Registered Land Surveyor  
 DATE: 1/27/04

E.I.: 21, 25