

LINCOLN COUNTY




13 - T34N - R6E
Section Town Range

BRADLEY
Township

SECTION SUMMARY

N

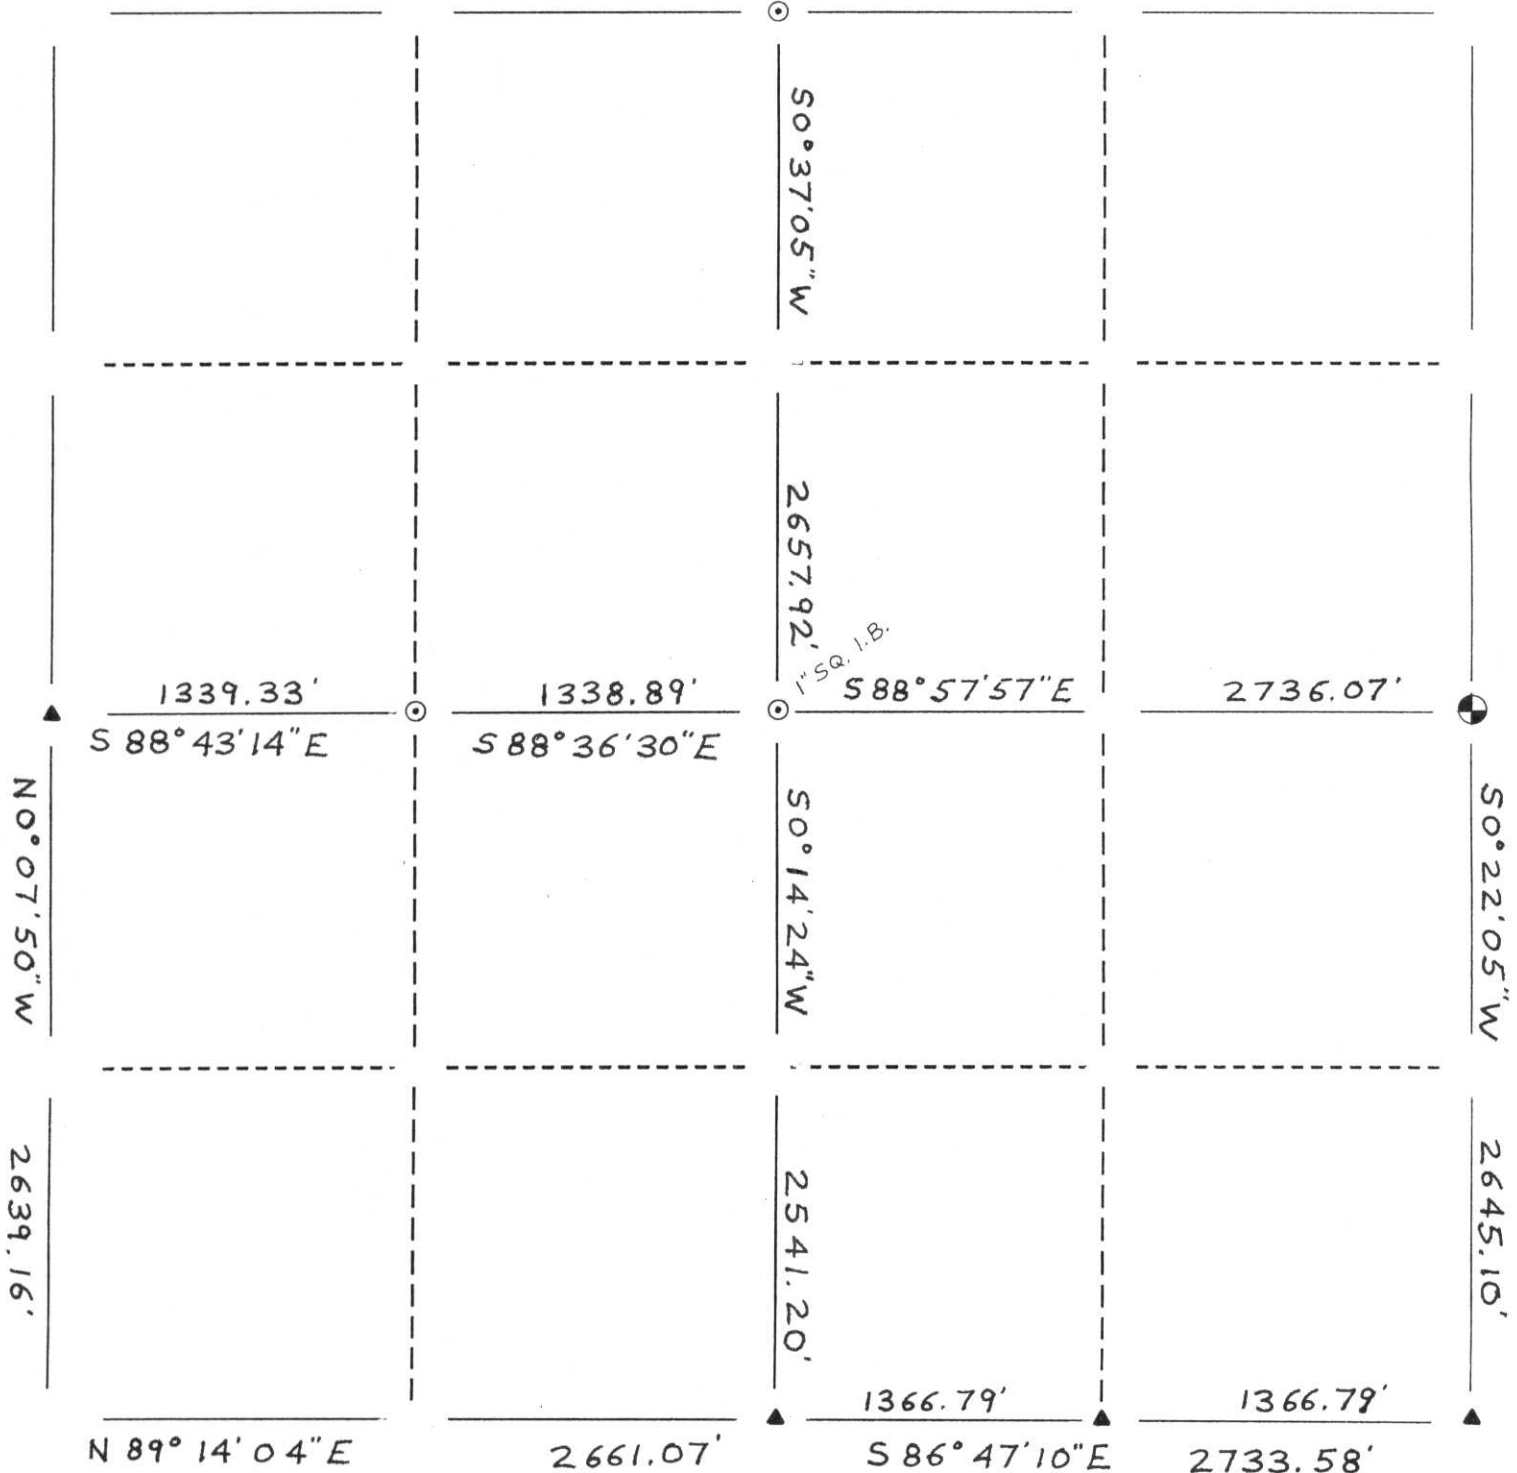

LEGEND

- ⊕ Berntsen Monument
- ⊙ IRON BAR
- 2" Iron Pipe
- Stone or Concrete Monument
- 1" Iron Pipe
- Iron Pipe
- ▲ Other EXISTING NAIL



RECEIVED BY LINCOLN COUNTY
SURVEYOR THIS 4TH DAY
OF November 20 07
Tom Dalk
COUNTY SURVEYOR

CERTIFIED CORRECT:
David J. Goslin
DAVID J. GOSLIN
Registered Land Surveyor

DATE: 10-11-04

I-M, 21-25