


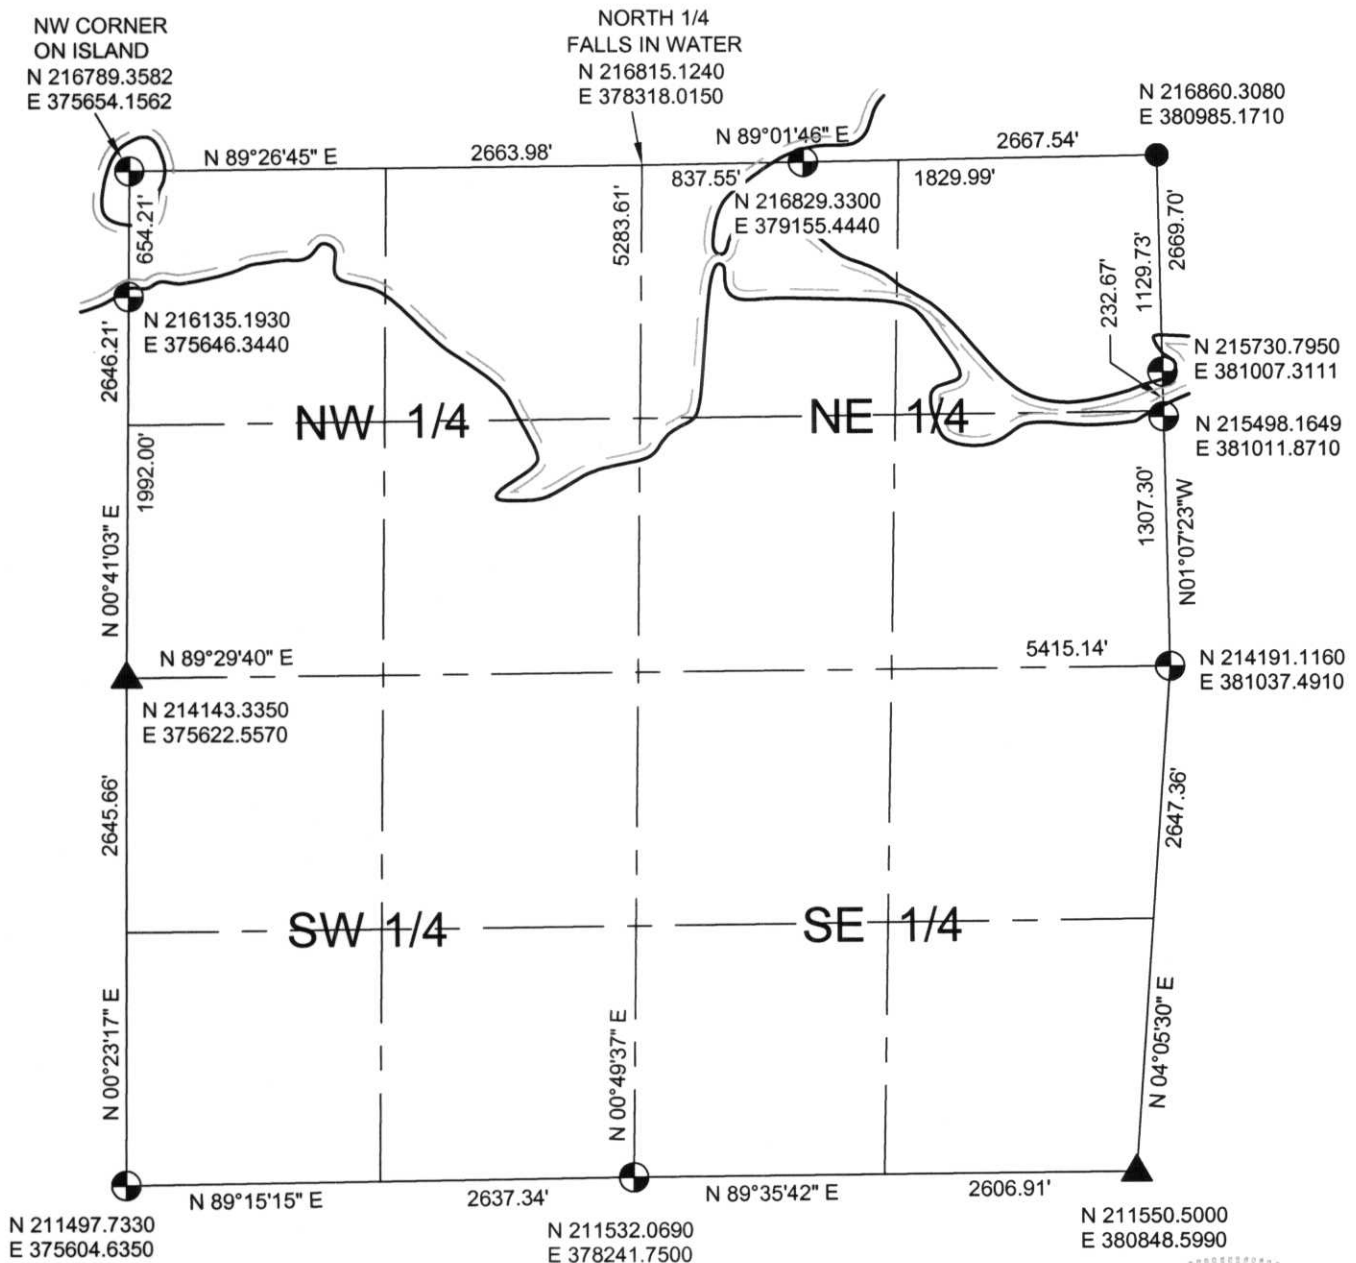

SECTION SUMMARY
 16 - 34N - 6E
 Section Township Range
BRADLEY
 Town

RECEIVED AT LINCOLN COUNTY
 COURTHOUSE THIS 9TH DAY
 OF January 20 02
Tommy Dalton
 LAND INFORMATION OFFICE



NOTES:
 COORDINATES AND BEARINGS ARE REFERENCED TO THE LINCOLN COUNTY
 COORDINATE SYSTEM AS DEVELOPED BY THE WISCONSIN DEPARTMENT OF
 TRANSPORTATION AND WERE DETERMINED BY GPS OBSERVATIONS ON CONTROL
 POINTS AS SUPPLIED BY THE DOT.

LEGEND

- - Lincoln County Monument
- - Stone Monument
- - 1-1/2" Iron Pipe
- - 2" Iron Pipe
- △ - Spike
- ▲ - MAG Nail to be tied out by County Surveyor



CERTIFIED CORRECT:
Thomas A. Radenz
 Registered Land Surveyor
 DATE: 1/8/02

T.M.: 9/13