




SECTION SUMMARY  
 28 - 34N - 6E  
 Section Township Range  
**BRADLEY**  
 Town

RECEIVED AT LINCOLN COUNTY  
 COURTHOUSE THIS 9<sup>TH</sup> DAY  
 OF January 20 02  
*Tommy Dalko*  
 LAND INFORMATION OFFICE

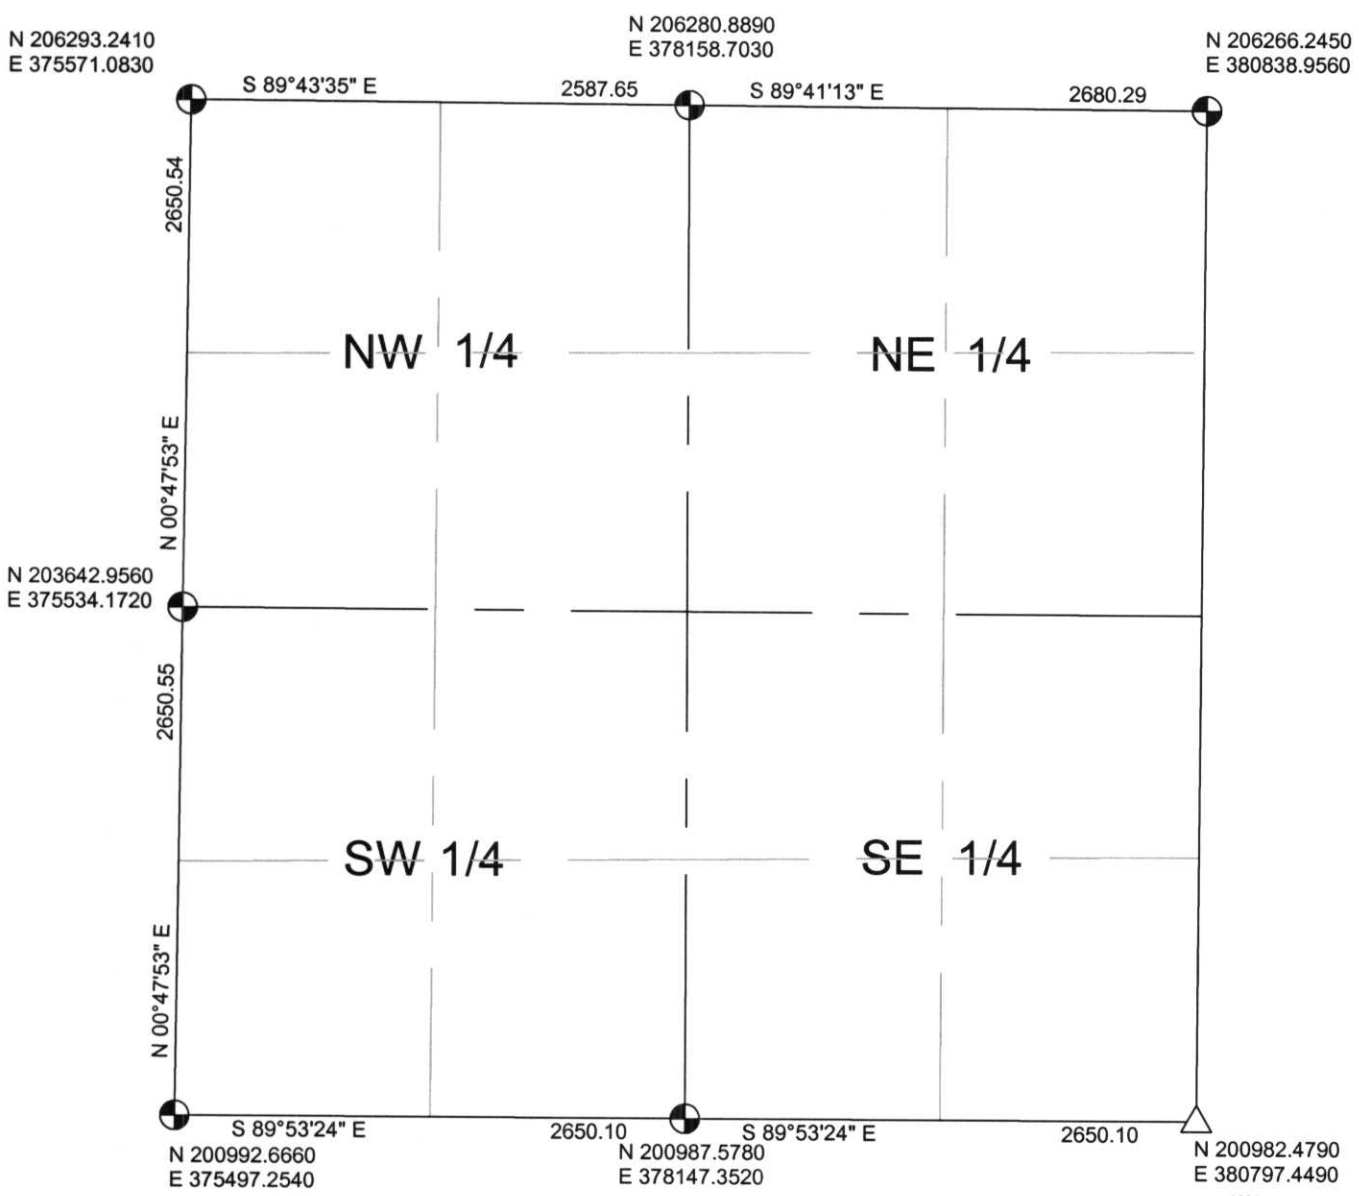

NOTES:  
 COORDINATES AND BEARINGS ARE REFERENCED TO THE LINCOLN COUNTY  
 COORDINATE SYSTEM AS DEVELOPED BY THE WISCONSIN DEPARTMENT OF  
 TRANSPORTATION AND WERE DETERMINED BY GPS OBSERVATIONS ON CONTROL  
 POINTS AS SUPPLIED BY THE DOT.

- LEGEND**
- ⊕ - Lincoln County Monument
  - - Stone Monument
  - - 1-1/2" Iron Pipe
  - - 2" Iron Pipe
  - △ - PK NAIL



CERTIFIED CORRECT:  
*Thomas A. Radenz*  
 Registered Land Surveyor  
 DATE: 1/8/02

DU: 9/13