


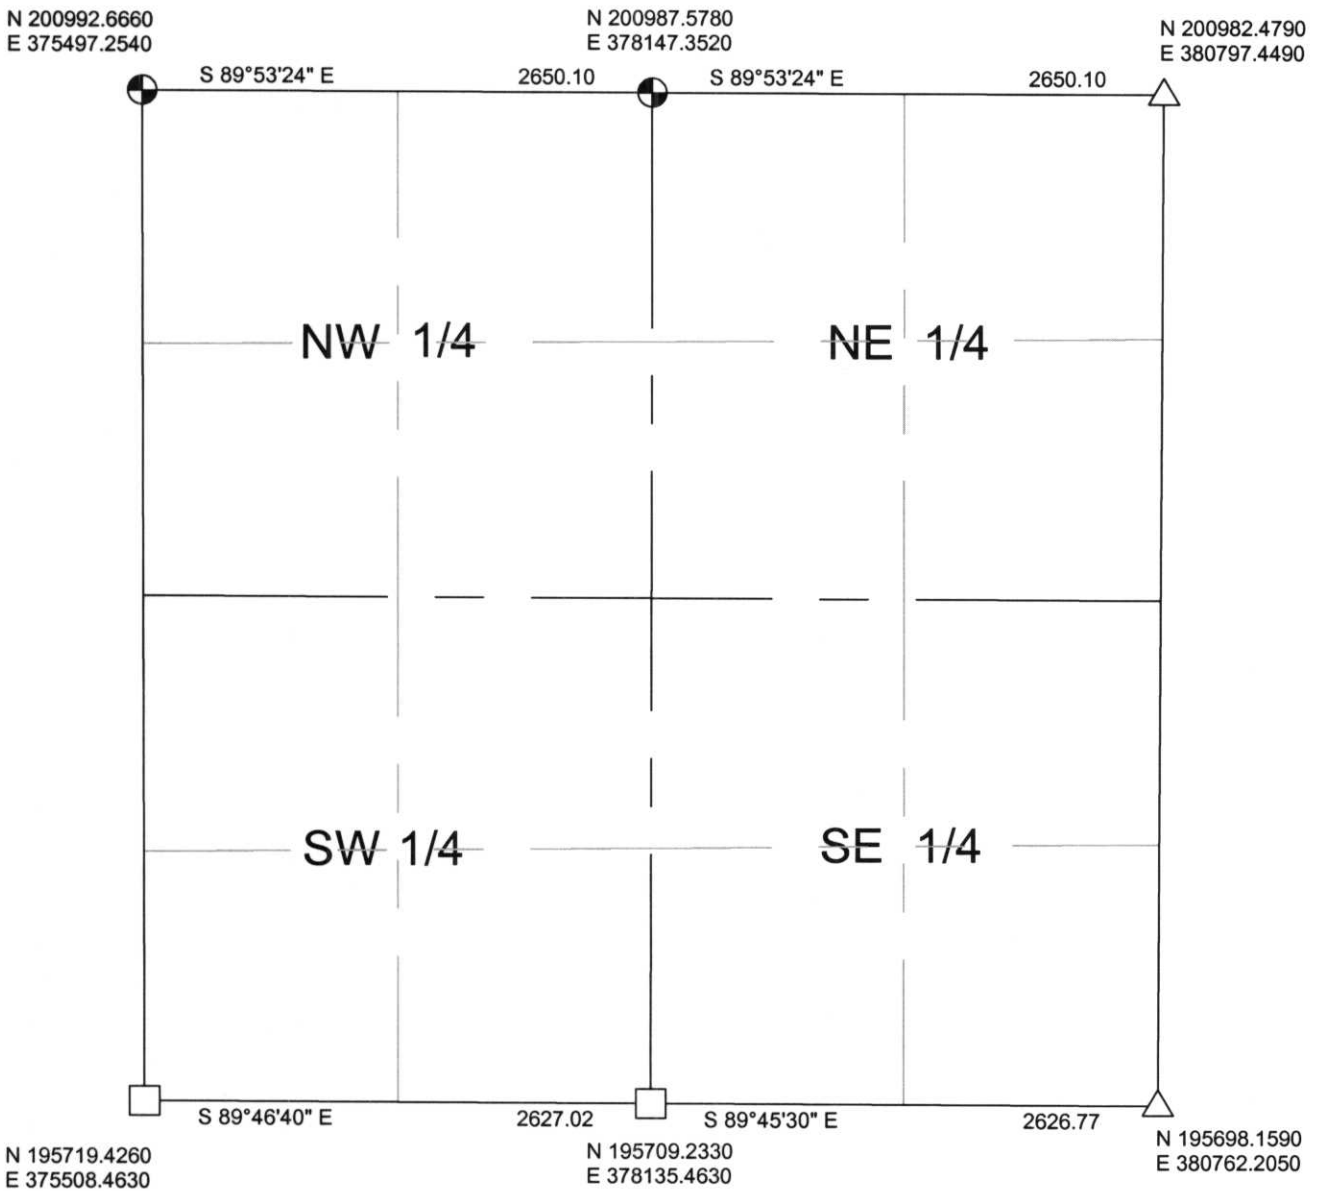

SECTION SUMMARY 33 - 34N - 6E
Section Township Range
BRADLEY
Town

RECEIVED AT LINCOLN COUNTY
COURTHOUSE THIS 9TH DAY
OF January 20 02
Tom Dalko
LAND INFORMATION OFFICE



NOTES:
COORDINATES AND BEARINGS ARE REFERENCED TO THE LINCOLN COUNTY COORDINATE SYSTEM AS DEVELOPED BY THE WISCONSIN DEPARTMENT OF TRANSPORTATION AND WERE DETERMINED BY GPS OBSERVATIONS ON CONTROL POINTS AS SUPPLIED BY THE DOT.

LEGEND

- ⊕ - Lincoln County Monument
- - Stone Monument
- - 1-1/2" Iron Pipe
- - 2" Iron Pipe
- △ - PK NAIL



CERTIFIED CORRECT:

Thomas A. Radenz
Registered Land Surveyor

DATE: 1/8/02

W/ 9/13